

CARD MUST BE TYPED

State of Kansas  
**NOTICE OF INTENTION TO DRILL** \*Corrected Footage & Elevation  
(see rules on reverse side) 8-7-85 CARD MUST BE SIGNED

Starting Date: August 6, 1985  
month day year

API Number 15- 051-24,282 - 0000  
SE NE NE.. Sec .25 Twp .11. S, Rge .17.  East  
(location)  West

OPERATOR: License # 5447  
Name Cities Service Oil & Gas Corp.  
Address 800 Sutton Place Bldg., 209 E. William  
City/State/Zip Wichita, Kansas 67202  
Contact Person Charles W. Horsman  
Phone 316.265-5624

\*4460 Ft North from Southeast Corner of Section  
\*440 Ft West from Southeast Corner of Section  
(Note: Locate well on Section Plat on reverse side)

CONTRACTOR: License # 5422  
Name Abercrombie Drilling, Inc.  
City/State 801 Union Center, Wichita, KS

Nearest lease or unit boundary line \*440 feet.  
County Ellis  
Lease Name Colaban "B" Well# 26.SWD

Well Drilled For: Well Class: Type Equipment:  
 Oil  Swd  Infield  Mud Rotary  
 Gas  Inj  Pool Ext.  Air Rotary  
 OWWO  Expl  Wildcat  Cable

Domestic well within 330 feet:  yes  no  
Municipal well within one mile:  yes  no

If OWWO: old well info as follows:

Operator  
Well Name  
Comp Date Old Total Depth  
Projected Total Depth 3900 feet  
Projected Formation at TD Granite Wash  
Expected Producing Formations

Depth to Bottom of fresh water 60 feet  
Lowest usable water formation Dakota  
Depth to Bottom of usable water 700 feet  
Surface pipe by Alternate: 1  2   
Surface pipe to be set 200 feet  
Conductor pipe if any required None feet  
Ground surface elevation \*1850 feet MSL  
This Authorization Expires 1-30-86  
Approved By 7-30-85


I certify that we will comply with K.S.A. 55-101, et seq., plus eventually plugging hole to K.C.C. specifications. \*WQS: 4290 FSL  
Date 7/29/85 Signature of Operator or Agent Charles W. Horsman Title Petroleum Engineer  
Charles W. Horsman

CORRECTED LOCATION

Must be filed with the K.C.C. five (5) days prior to commencing well  
 This card void if drilling not started within six (6) months of date received by K.C.C.

**Important procedures to follow :**

**A Regular Section of Land**  
**1 Mile = 5,280 Ft.**

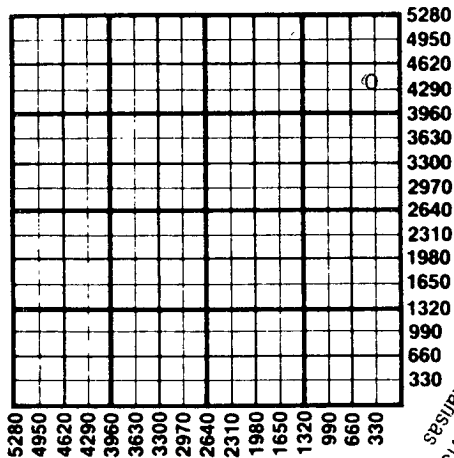

1. Notify District office before setting surface casing.
2. Set surface casing by circulating cement to the top.
3. File completion forms ACO-1 with K.C.C. within 90 days of well completion, following instructions on ACO-1, side 1, and including copies of wireline logs.
4. Notify District office 48 hours prior to old well workover or re-entry.
5. Prior to plugging, prepare a plugging plan, then obtain agreement from the appropriate district office for an approved plugging plan.
6. Submit plugging report (CP-4) to K.C.C. after plugging is completed.
7. Obtain an approved injection docket number before disposing of salt water.
8. Notify K.C.C. within 10 days when injection commences or terminates.
9. If an alternate 2 completion, cement in the production pipe from below any usable water to surface within 120 days of spud date.

**State Corporation Commission of Kansas**  
**Conservation Division**  
**200 Colorado Derby Building**  
**Wichita, Kansas 67202**  
**(316) 263-3238**

RECEIVED  
 STATE CORPORATION COMMISSION  
 AUG 7 1985  
 CONSERVATION DIVISION  
 WICHITA, KANSAS

88-70-80