

CARD MUST BE TYPED

State of Kansas
NOTICE OF INTENTION TO DRILL
(see rules on reverse side)

CARD MUST BE SIGNED

Starting Date: August 14, 1985
month day year 3:37

API Number 15- 051-24,293 0000

OPERATOR: License # 5447
Name Cities Service Oil & Gas Corporation
Address 800 Sutton Place Bldg., 209 E. William
City/State/Zip Wichita, Kansas 67202
Contact Person Charles W. Horsman
Phone 316 265-5624

NE/4 Sec 25 Twp 11 S, Rge 17
(Location)
5020 Ft North from Southeast Corner of Section
1320 Ft West from Southeast Corner of Section
(Note: Locate well on Section Plat on reverse side)

CONTRACTOR: License # 5422
Name Abercrombie Drilling, Inc.
City/State 801 Union Center, Wichita, KS

Nearest lease or unit boundary line 260 feet.
County Ellis
Lease Name Colahan "B" Well# 26-A.SWD
Domestic well within 330 feet: yes no
Municipal well within one mile: yes no

Well Drilled For: Well Class: Type Equipment:
 Oil Swd Infield Mud Rotary
 Gas Inj Pool Ext. Air Rotary
 OWWO Expl Wildcat Cable

Depth to Bottom of fresh water 60 feet
Lowest usable water formation Dakota
Depth to Bottom of usable water 7.00 feet
Surface pipe by Alternate: 1 2
Surface pipe to be set 1.700 feet
Conductor pipe if any required None feet
Ground surface elevation 1878 feet MSL
This Authorization Expires 2-13-86
Approved By 8-13-85

If OWWO: old well info as follows:
Operator
Well Name
Comp Date Old Total Depth
Projected Total Depth 3900 feet
Projected Formation at TD Granite Wash
Expected Producing Formations

I certify that we will comply with K.S.A. 55-101, et seq., plus eventually plugging hole to K.C.C. specifications.

Date 8/13/85 Signature of Operator or Agent

Charles W. Horsman Title Petroleum Engineer
Form C-1 4/84

RECEIVED

STATE CORPORATION COMMISSION Must be filed with the K.C.C. five (5) days prior to commencing well
This card void if drilling not started within six (6) months of date received by K.C.C.

AUG 13 1985


08-13-85

CONSERVATION DIVISION

Wichita, Kansas

A Regular Section of Land

1 Mile = 5,280 Ft.

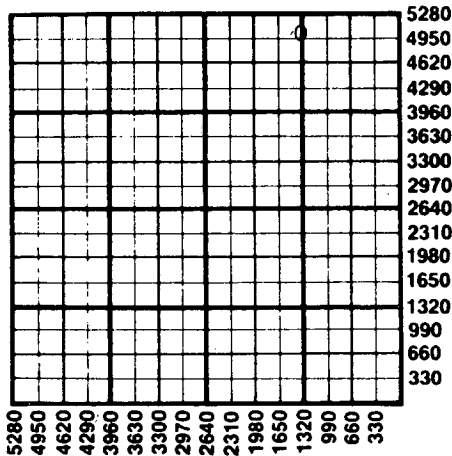

Important procedures to follow :

1. Notify District office before setting surface casing.
2. Set surface casing by circulating cement to the top.
3. File completion forms ACO-1 with K.C.C. within 90 days of well completion, following instructions on ACO-1, side 1, and including copies of wireline logs.
4. Notify District office 48 hours prior to old well workover or re-entry.
5. Prior to plugging, prepare a plugging plan, then obtain agreement from the appropriate district office for an approved plugging plan.
6. Submit plugging report (CP-4) to K.C.C. after plugging is completed.
7. Obtain an approved injection docket number before disposing of salt water.
8. Notify K.C.C. within 10 days when injection commences or terminates.
9. If an alternate 2 completion, cement in the production pipe from below any usable water to surface within 120 days of spud date.

State Corporation Commission of Kansas
 Conservation Division
 200 Colorado Derby Building
 Wichita, Kansas 67202
 (316) 263-3238