

STATE OF KANSAS  
STATE CORPORATION COMMISSION


Form CP-4

WELL PLUGGING RECORD

Give All Information Completely  
Make Required Affidavit  
Mail or Deliver Report to:  
Conservation Division  
State Corporation Commission  
P. O. Box 17027  
Wichita, Kansas 67217  
NORTH

Ellis County, Sec. 26 Twp. 11S Rge. (E) 17 (W)

Location as "NE/CNW&SW&" or footage from lines SW NE NW  
Lease Owner Cities Service Oil Company  
Lease Name Hall "B" Well No. 12  
Office Address Box 553 Russell, Kansas 67665  
Character of Well (completed as Oil, Gas or Dry Hole) Oil  
Date well completed 5-12 19 39  
Application for plugging filed 11-12 19 71  
Application for plugging approved 11-15 19 71  
Plugging commenced 2-25 19 72  
Plugging completed 2-25-72 19  
Reason for abandonment of well or producing formation Depleted

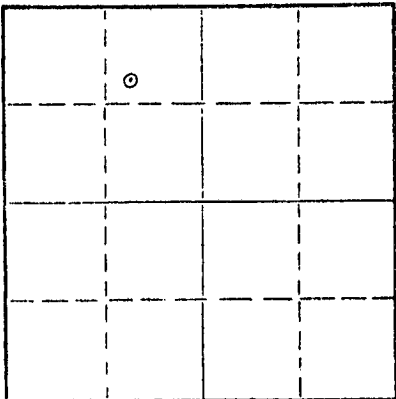

Locate well correctly on above  
Section Plat

If a producing well is abandoned, date of last production 5-8 19 67  
Was permission obtained from the Conservation Division or its agents before plugging was commenced? Yes

Name of Conservation Agent who supervised plugging of this well Mr. Leo Massey  
Producing formation Lansing-Kansas City Depth to top 3203' Bottom 3408' Total Depth of Well 3467 Feet  
Show depth and thickness of all water, oil and gas formations.

OIL, GAS OR WATER RECORDS

CASING RECORD

FORMATION	CONTENT	FROM	TO	SIZE	PUT IN	PULLED OUT
				8 5/8"	1055'	None
				5 1/2"	3460'	None

Describe in detail the manner in which the well was plugged, indicating where the mud fluid was placed and the method or methods used in introducing it into the hole. If cement or other plugs were used, state the character of same and depth placed, from \_\_\_\_\_ feet to \_\_\_\_\_ feet for each plug set.

Ran 3000' 2" tubing and Halliburton pumped in 25 Sx. cement. Pulled tubing to 2790. Pumped 25 sx. gel. Pulled tubing to 540'. Pumped 75 sx. cement. Pulled tubing out. Ran 240' 3/4" pipe in annulus (5 1/2" x 8 5/8") Pumped 25 sx. cement to surface.

RECEIVED  
STATE CORPORATION COMMISSION  
APR 13 1972  
CONSERVATION DIVISION  
Wichita, Kansas

04-13-72

(If additional description is necessary, use BACK of this sheet)

Name of Plugging Contractor Halliburton Company  
Address Hays, Kansas

STATE OF Kansas COUNTY OF Russell, ss.  
E. W. Peterman (employee of owner) or (owner or operator) of the above-described well, being first duly sworn on oath, says: That I have knowledge of the facts, statements, and matters herein contained and the log of the above-described well as filed and that the same are true and correct. So help me God.

(Signature) *E. W. Peterman*  
Box 553 Russell, Kansas 67665


Subscribed and sworn to before me this 12th day of April, 19 72

My commission expires

10-5-72

*James H. Ryan*

Notary Public.

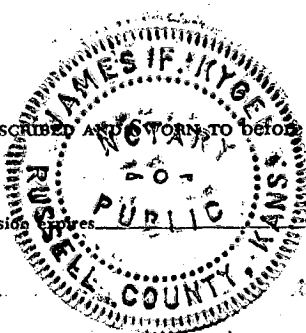

WELL RECORD


Company Cities Service Oil Co. No 12-B Farm Hall "B"  
 Location 990' S, 990' W, N/4 CORNER Sec. 26 T. 11 R. 17-W  
 Elevation 1997 County Ellis State Kansas  
 Date Comm. Apr. 22, 1939  
 Date Completed May 12, 1939 Initial Production 15,667 (Echo-Meter)  
 Contractor: J. E. Mabee Company

Total Depth 3467

CASING RECORD:

8-5/8" 1055' - cem. 300 cement, 25 OilMax, 75 Aquagel  
 6-5/16" 3460' - cem. 100 cement, 15 Aquagel

FORMATION RECORD:

shale & shells 0-370  
 shale 385  
 sand 530  
 shale & sand 725  
 shale 760  
 sand 820  
 shale & shells & sand 900  
 red bed 990  
 red bed & shells 1089  
 shale 1178  
 anhydrite 1228  
 red bed 1330  
 shale, shells & red bed 1417  
 shale & shells 1550  
 salt 1745  
 shale & lime 1940  
 lime 1993  
 lime & shale 2095  
 lime broken 2153  
 shale 2178  
 shale & shells 2480  
 shale & lime 2647  
 shale 2715  
 lime broken 2764  
 lime & shale 2886  
 lime 2990  
 lime & shale 2980  
 lime 3218  
 lime & shale 3256  
 lime broken 3312  
 lime 3461  
 T. D. rotary 3461 = 3461  
 lime 3467

Top Arbuckle 3459  
 Penetration 8  
 Total Depth 3467  
 Pay 3460-61 1/2

Fillup:  
 700' in 30 min.  
 1500' in 45 min.  
 2350' in 2 1/2 hrs.

Syfo: 250' 00  
 500' 00  
 1500' 00  
 2000' 00  
 2500' 00  
 2850' 00  
 3080' 00

RECEIVED  
 STATE CORPORATION COMMISSION  
 NOV 15 1971  
 CONSERVATION DIVISION  
 Wichita, Kansas