

STATE OF KANSAS
STATE CORPORATION COMMISSION

WELL PLUGGING RECORD

Give All Information Completely
Make Required Affidavit
Mail or Deliver Report to:
Conservation Division
State Corporation Commission
800 Bittling Building
Wichita, Kansas

Ellis County. Sec. 23 Twp. 11S Rge. (E) 17(W)

Location as "NE/CNW/SW" or footage from lines NE SE NW

Lease Owner Shell Oil Company

Lease Name J. L. RUMSEY Well No. 15

Office Address P. O. Box 744, Great Bend, Kansas

Character of Well (completed as Oil, Gas or Dry Hole) Oil

Date well completed November 15 19 38

Application for plugging filed May 15 19 59

Application for plugging approved May 19 19 59


Plugging commenced May 18 19 59

Plugging completed May 26 19 59

Reason for abandonment of well or producing formation Oil Depleted

If a producing well is abandoned, date of last production March 4 19 59

Was permission obtained from the Conservation Division or its agents before plugging was commenced? Yes

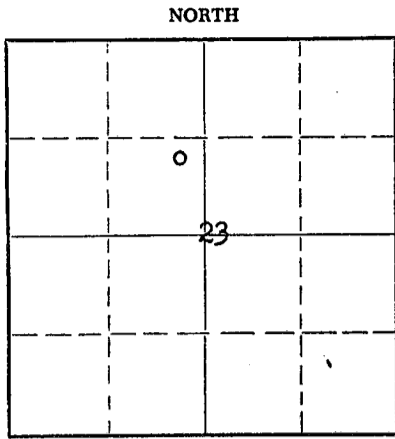

Locate well correctly on above Section Plat

Name of Conservation Agent who supervised plugging of this well Eldon Petty

Producing formation Arbuckle Depth to top 3375 Bottom Total Depth of Well 3385 Feet

Show depth and thickness of all water, oil and gas formations.

OIL, GAS OR WATER RECORDS CASING RECORD


FORMATION	CONTENT	FROM	TO	SIZE	PUT IN	PULLED OUT
Arbuckle	I.P. 3465 BO,	3376	3385	16"	120'	None
	no water 24			10 3/4"	1096'	None
	hours.			7"	3376	2612'

Describe in detail the manner in which the well was plugged, indicating where the mud fluid was placed and the method or methods used in introducing it into the hole. If cement or other plugs were used, state the character of same and depth placed, from feet to feet for each plug set.

Filled hole with sand to 3360 & dumped 5 sax cement to 3336. Loaded hole with water; shot 7" casing; pulled casing up to 670. Pumped in & balanced 26 sax mud (78 bbls) at 670. Pulled casing up to 450. Pumped in 30 sax cement at 450. Pulled 7" casing up to 170. Pumped in 30 sax cement at 170. Finished pulling casing. Filled hole with mud to 35, set rock bridge to 25 & filled to base of cellar with 10 sax cement.

(If additional description is necessary, use BACK of this sheet)

Name of Plugging Contractor Forbes Casing Pulling Company
Address Box 221, Great Bend, Kansas

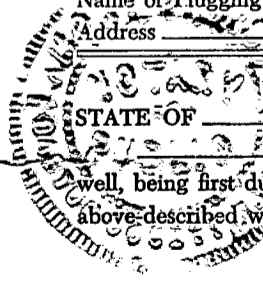

STATE OF KANSAS, COUNTY OF BARTON, ss.

A. W. Weber (employee of owner) Notary Public of the above-described well, being first duly sworn on oath, says: That I have knowledge of the facts, statements, and matters herein contained and the log of the above-described well as filed and that the same are true and correct. So help me God.

(Signature) A. W. Weber
P. O. Box 744, Great Bend, Kansas (Address)

SUBSCRIBED AND SWORN TO before me this 28th day of May, 19 59

LaMont Byers, Jr. Notary Public.

My commission expires January 28, 1961

24-7968-S 3-53-20M

RECEIVED
STATE CORPORATION COMMISSION

JUN 1 1959

CONSERVATION DIVISION
Wichita, Kansas

LB

PLUGGING
FILE SEC 23 T. 11 S. R. 17 W
BOOK PAGE 39 LINE 21

15-051-05889-0000

SHELL-J. L. RUMSEY #15
NE SE NW Section 23-11S-17W
Bemis-Shutts Field
Ellis County, Kansas

Casing Record

16" cem 120 with 150 sax
10-3/4" cem 1096 with 350 sax
7" cem 3376 with 200 sax

0 - 115 surface clay
123 red rock
450 shale & shells
490 sand & gravel
660 red rock & shells
735 water sand
794 red bed & shells
1082 red bed
1125 anhydrite
1175 red rock
1360 red bed
1465 red rock & shells
1672 salt
1742 shale & broken lime
1820 shale & shells
1943 shale & broken lime
2019 broken lime & shale
2050 broken lime
2070 shale & shells
2178 broken lime
2275 shale & shells
2340 lime
2415 broken lime
2480 broken lime & shale
2791 shale & shells
2805 lime
2835 shale & shells
Top Topeka 2823
Top Lansing-Kansas City 3119
3332 lime
Top Sooy Conglomerate 3332
3352 conglomerate
Top Simpson 3352
3362 dolomite
3371 shale
3372 sand
3375 shale
Top Arbuckle 3375
3385 dolomite T.D.

STAT

CLASSIC

MAY 16 1959

LB

CO

DIVISION

Kansas

PLUGGING	
FILE	SEC. 23 T. 11 R. 17W
BOOK	PAGE 39 LINE 21