


STATE OF KANSAS
STATE CORPORATION COMMISSION
Give All Information Completely
Make Required Affidavit
Mail or Deliver Report to:
Conservation Division
State Corporation Commission
211 No. Broadway
Wichita, Kansas

WELL PLUGGING RECORD

Ellis County. Sec. 23 Twp. 11 Rge. (E) 17 (W)
Location as "NE/CNW/SW" or footage from lines SE - NW
Lease Owner Great Bend Pipe & Supply
Lease Name J. L. Rumsey Well No. 16
Office Address Great Bend, Kansas
Character of Well (completed as Oil, Gas or Dry Hole)
Date well completed 19
Application for plugging filed 19
Application for plugging approved 19
Plugging commenced 12-18 19 57
Plugging completed 12-21 19 57
Reason for abandonment of well or producing formation
If a producing well is abandoned, date of last production 19
Was permission obtained from the Conservation Division or its agents before plugging was commenced? Yes

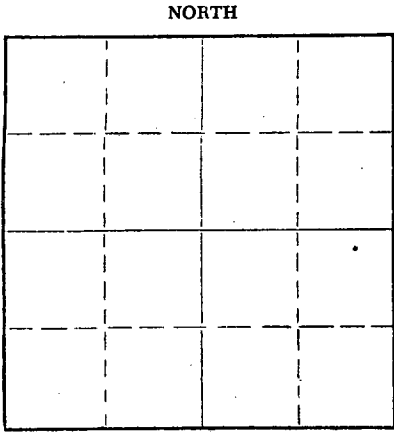

Locate well correctly on above Section Plat

Name of Conservation Agent who supervised plugging of this well Eldon Petty
Producing formation Depth to top Bottom Total Depth of Well Feet
Show depth and thickness of all water, oil and gas formations.

OIL, GAS OR WATER RECORDS

CASING RECORD

| FORMATION | CONTENT | FROM | TO | SIZE | PUT IN | PULLED OUT |
|-----------|---------|------|----|--------|--------|------------|
| | | | | 16 | 130 | None |
| | | | | 10 3/4 | 1118 | None |
| | | | | 7 | 3400 | 2634.20 |
| | | | | | | |
| | | | | | | |
| | | | | | | |
| | | | | | | |
| | | | | | | |
| | | | | | | |

Describe in detail the manner in which the well was plugged, indicating where the mud fluid was placed and the method or methods used in introducing it into the hole. If cement or other plugs were used, state the character of same and depth placed, from feet to feet for each plug set.

Sanded to 3300 - dumped 5 sks cement - pulled pipe -
jetted Jell-mud in hole to 450' - set 10' rock bridge - dumped 20 sks cement
jetted Jell-mud to 250' - set 10' rock bridge - dumped 20 sks cement -
jetted Jell-mud to 35' - set 10' rock bridge - dumped 10 sks cement.

RECEIVED
STATE CORPORATION COMMISSION
DEC 28 1957
CONSERVATION DIVISION
Wichita, Kansas
12-28-57

(If additional description is necessary, use BACK of this sheet)
Name of Plugging Contractor R & D Casing Pulling Company License # 236
Address Box 569 Ellinwood, Kansas

STATE OF Kansas COUNTY OF Barton, ss.
Nathan Melty (employee of owner) or (owner or operator) of the above-described well, being first duly sworn on oath, says: That I have knowledge of the facts, statements, and matters herein contained and the log of the above-described well as filed and that the same are true and correct. So help me God.

(Signature) Nathan Melty
Box 414, Great Bend, Kansas (Address)

SUBSCRIBED AND SWORN TO before me this 26th day of December, 19 57
My commission expires 3/30/61
Notary Public.

PLUGGING
FILE SEC 23 T 11 R 170
BOOK PAGE 69 LINE 30