


WELL PLUGGING RECORD

Give All Information Completely
Make Required Affidavit
Mail or Deliver Report to:
Conservation Division
State Corporation Commission
800 Biting Building
Wichita, Kansas

Ellis County, Sec. 23 Twp. 11S Rge. (E) 17 (W)

Location as "NE/CNW&SW&" or footage from lines SW/SW/NE
Lease Owner Shell Oil Company
Lease Name J. L. Rumsey Well No. 20
Office Address Box 744, Great Bend, Kansas
Character of Well (completed as Oil, Gas or Dry Hole) Oil
Date well completed July 24 19 39
Application for plugging filed Sept. 28 19 59
Application for plugging approved Sept. 29 19 59
Plugging commenced Sept. 30 19 59
Plugging completed October 6 19 59
Reason for abandonment of well or producing formation Oil Depleted

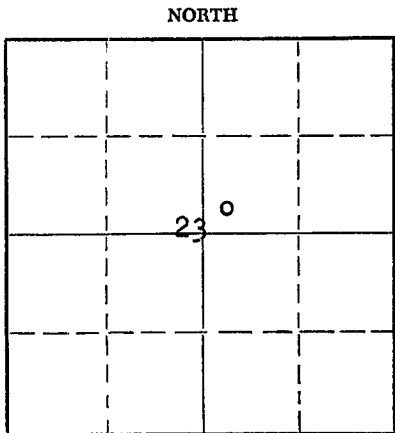

Locate well correctly on above Section Plat

If a producing well is abandoned, date of last production August 2 19 59
Was permission obtained from the Conservation Division or its agents before plugging was commenced? Yes

Name of Conservation Agent who supervised plugging of this well Eldon Petty
Producing formation Arbuckle Depth to top 3389 Bottom - Total Depth of Well 3399 Feet
Show depth and thickness of all water, oil and gas formations.

OIL, GAS OR WATER RECORDS

CASING RECORD

FORMATION	CONTENT	FROM	TO	SIZE	PUT IN	PULLED OUT
Arbuckle	I.C. 46110	3390	3399	13"	131	None
	BO, NW.			8-5/8"	1098	None
				4-1/2"	3390	2600'

Describe in detail the manner in which the well was plugged, indicating where the mud fluid was placed and the method or methods used in introducing it into the hole. If cement or other plugs were used, state the character of same and depth placed, from feet to feet for each plug set.

Filled hole w/ sand to 3380 & dumped 3 sax cement to 3344.
Loaded hole w/ water; shot & pulled casing. Pumped in and circulated 15 sax Gel mud by Hal Hurton; balanced same.
Pumped in 20 sax cement 500-436. Mudded 436-160. Pumped in 20 sax cement 160-96. Mudded 96-35. Filled w/ rock 35-25 & dumped 10 sax cement to base of cellar.

RECEIVED
STATE CORPORATION COMMISSION

OCT 15 1959
10-15-59
CONSERVATION DIVISION
Wichita, Kansas

(If additional description is necessary, use BACK of this sheet.)
Name of Plugging Contractor Forbes Casing Pulling Co.
Address Box 221, Great Bend, Kansas

STATE OF Kansas, COUNTY OF Barton, ss.
A. W. Weber (employee of owner) of the above-described well, being first duly sworn on oath, says: That I have knowledge of the facts, statements, and matters herein contained and the log of the above-described well as filed and that the same are true and correct. So help me God.

(Signature) A. W. Weber
Box 744, Great Bend, Kansas
(Address)

SUBSCRIBED AND SWORN TO before me this 11th day of October, 1959

My commission expires January 28, 1961

LaMont Byers, Jr. Notary Public.

SHELL-J. L. RUMSEY #20
SW SW NE Section 23-11S-17W
Bemis-Shutte Field
Ellis County, Kansas

Casing Record

13" cem 131 with 125 sax
8 5/8" cem 1098 with 325 sax
4 1/2" cem 3390 with 100 sax

- 0 - 33 clay
- 142 shale & shells
- 242 shale
- 545 shale & shells
- 603 sand
- 620 shale
- 666 shale & shells
- 685 lime
- 725 shale & shells
- 758 sand
- 877 shale & lime
- 993 shale & lime shells
- 1057 shale
- 1087 lime & shale streaks
- 1147 anhydrite
- 1200 red shale
- 1364 shale & shells
- 1523 salt
- 1660 salt & shale
- 1856 lime & shale
- 1890 lime
- 1930 shale
- 1956 lime & shale streaks
- 2020 lime & shale
- 2052 lime
- 2110 lime & shale
- 2130 lime
- 2147 shale
- 2192 lime
- 2242 lime & shale
- 2270 shale
- 2288 sand
- 2338 lime & shale
- 2396 lime & shale streaks
- 2440 lime & shale
- 2458 lime
- 2570 shale & lime
- 2622 shale
- 2694 shale & lime streaks
- 2787 lime & shale
- 2805 shale & shells
- 2834 lime & shale
- 3088 lime
- 3129 lime & shale
- 3283 lime
- 3312 lime & shale streaks
- 3352 lime
- 3365 conglomerate
- 3374 dolomite
- 3384 shale
- 3385 sand

3388 shale
3390 dolomite
3390=3391 SLC
3399 dolomite, few sand grains &
trace chert T.D.

Formation Tops:

Topeka 2827
Lansing-Kansas City 3133
Sooy Conglomerate 3353
Simpson Series 3366
Arbuckle 3389

RECEIVED
STATE CORPORATION COMMISSION
SEP 29 1959
CONSERVATION DIVISION
Wichita, Kansas