


WELL PLUGGING RECORD

Give All Information Completely
Make Required Affidavit
Mail or Deliver Report to:
Conservation Division
State Corporation Commission
211 No. Broadway
Wichita, Kansas

NORTH

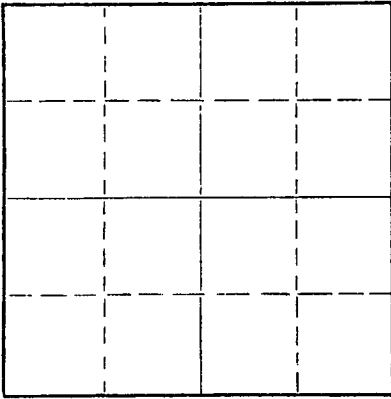

Locate well correctly on above
Section Plat

Ellis County. Sec. 23 Twp. 11S Rge. 17 (H) (W)
Location as "NE/CNW&SW" or footage from lines NE 1/4/NE 1/4
Lease Owner Forbes Casing Pulling Co.
Lease Name J.L. Rumsey Well No. #23
Office Address Box 221, Great Bend, Kansas
Character of Well (completed as Oil, Gas or Dry Hole) _____
Date well completed _____ 19____
Application for plugging filed Yes 19____
Application for plugging approved Yes 19____
Plugging commenced 4-28 19 58
Plugging completed 5-7 19 58
Reason for abandonment of well or producing formation _____

If a producing well is abandoned, date of last production _____ 19____
Was permission obtained from the Conservation Division or its agents before plugging was commenced? Yes

Name of Conservation Agent who supervised plugging of this well Mr. Eldon Petty
Producing formation _____ Depth to top _____ Bottom _____ Total Depth of Well 3409' Feet
Show depth and thickness of all water, oil and gas formations.

OIL, GAS OR WATER RECORDS

CASING RECORD

FORMATION	CONTENT	FROM	TO	SIZE	PUT IN	PULLED OUT
				8 5/8"		
				4 1/2"		2,729'

Describe in detail the manner in which the well was plugged, indicating where the mud fluid was placed and the method or methods used in introducing it into the hole. If cement or other plugs were used, state the character of same and depth placed, from _____ feet to _____ feet for each plug set.

Measured into T.D. 3409'.
Plugging started 4-28-58. Finished 5-7-58.
Plugged off bottom with cement to 3379'. Circulated mud and spotted cement. Shot 4 1/2" casing at 2,729'. Circulated 45 sacks gel mud. Spotted 20 sacks cement. Pulled pipe to 250'. Spotted 20 sacks cement. Pulled rest of pipe. Filled hole with mud to 40', set rock bridge and mixed 10 sacks cement for cap on well. Well completed.

05-26-58

(If additional description is necessary, use BACK of this sheet)
Name of Plugging Contractor J.O. Forbes d/b/a Forbes Casing Pulling Co.
Address Box 221, Great Bend, Kansas

STATE OF Kansas COUNTY OF Barton, ss.
J.O. Forbes (employee of owner) or (owner or operator) of the above-described well, being first duly sworn on oath, says: That I have knowledge of the facts, statements, and matters herein contained and the log of the above-described well as filed and that the same are true and correct. So help me God.

(Signature) J.O. Forbes
Box 221, Great Bend, Kansas
(Address)

SUBSCRIBED AND SWORN TO before me this 22nd day of May, 1958

My commission expires November 8, 1960.
Betty S. Edman
Notary Public.

PLUGGING
FILE SEC. _____ R. _____
BOOK PAGE _____ LINE _____

SHELL-J. L. RUMSEY #23
 NE NE NE Section 23-11S-17W
 Bemis-Shutts Field
 Ellis County, Kansas

Casing Record

13" cem 134 with 125 sax
 8 5/8" cem 1097 with 325 sax
 4 1/2" cem 3400 with 100 sax

0 - 141 shale & sand streaks
 315 shale & shells
 400 sand & shale
 505 shale & lime shells
 560 sand
 665 shale & sand
 735 sand
 850 shale & lime
 1094 shale & shells
 1128 anhydrite
 1138 shale
 1410 shale & shells
 1449 shale & salt streaks
 1645 salt
 1765 anhydrite
 1800 shale & lime
 1834 lime
 2300 lime & shale
 2459 shale & lime streaks
 2595 shale
 2745 shale & lime
 2798 shale & lime streaks
 Top Topeka 2797
 2854 lime
 2933 lime & shale
 2960 lime
 3000 shale & lime
 3033 lime
 3054 lime & shale
 3334 lime
 Top LKC 3104
 3367 conglomerate
 Top Sooy Conglomerate 3332 SLC
 3373 dolomite
 Top Simpson Dolomite 3365 SLC
 3396 shale, hard, green
 3401 shale
 Top Arbuckle 3399 SLC
 3403 dolomite
 3403=3401 SLC
 3409 dolomite TD

RECEIVED
 STATE CORPORATION COMMISSION
 JAN 16 1958
 CONSERVATION DIVISION
 WICHITA, KANSAS

01-16-58

PLUGGING

FILE SEC. 23 T. 11 R. 17W
 BOOK PAGE 76 LINE 45