


Give All Information Completely
Make Required Affidavit
Mail or Deliver Report to:
Conservation Division
State Corporation Commission
212 North Market, Insurance Bldg.
Wichita, Kansas

WELL PLUGGING RECORD

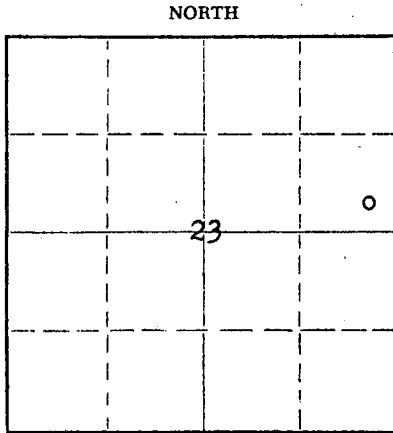

Locate well correctly on above Section Plat

Ellis County. Sec. 23 Twp. 11S Rge. 17 (W)
Location as "NE/CNW/SW" or footage from lines. SE SE NE
Lease Owner Shell Oil Company
Lease Name J. L. RUMSEY Well No. 25
Office Address 1845 Sherman Street, Denver 3, Colorado
Character of Well (completed as Oil, Gas or Dry Hole) Oil
Date well completed October 10 1939
Application for plugging filed April 24 1961
Application for plugging approved (Verbal) April 12 1961
Plugging commenced April 12 1961
Plugging completed April 19 1961
Reason for abandonment of well or producing formation Oil Depleted

If a producing well is abandoned, date of last production March 28 1961
Was permission obtained from the Conservation Division or its agents before plugging was commenced? Yes

Name of Conservation Agent who supervised plugging of this well Eldon Petty
Producing formation Arbuckle Depth to top 3421 Bottom - Total Depth of Well 3431 Feet
Show depth and thickness of all water, oil and gas formations.

OIL, GAS OR WATER RECORDS

CASING RECORD

| FORMATION | CONTENT | FROM | TO | SIZE | PUT IN | PULLED OUT |
|-----------|------------------------------|------|------|--------|--------|------------|
| Arbuckle | IC 74, 149 BO, NW, 24 hours. | 3422 | 3431 | 13" | 133' | None |
| | | | | 8 5/8" | 1145' | None |
| | | | | 4 1/2" | 3422' | 2773' |
| | | | | | | |
| | | | | | | |

Describe in detail the manner in which the well was plugged, indicating where the mud fluid was placed and the method or methods used in introducing it into the hole. If cement or other plugs were used, state the character of same and depth placed, from _____ feet to _____ feet for each plug set.

Filled hole with sand to 3400 & dumped 3
sx cement to 3364. Mudded hole to 460, circulated
30 sx Gel & spotted 20 sx cement 460-396. Mudded
hole to 150 & spotted 20 sx cement 150-113. Mudded
hole to 50, set rock bridge to 40 & capped to base
of cellar w/ 10 sx cement.

RECEIVED
STATE CORPORATION COMMISSION
APR 27 1961
CONSERVATION DIVISION
Wichita, Kansas
04-27-61

(If additional description is necessary, use BACK of this sheet)
Name of Plugging Contractor Forbes Casing Pulling Company
Address P. O. Box 221, Great Bend, Kansas


STATE OF Colorado COUNTY OF Denver, ss.
J. E. Tuttle (employee of owner) or ~~owner's representative~~ of the above-described well, being first duly sworn on oath, says: That I have knowledge of the facts, statements, and matters herein contained and the log of the above-described well as filed and that the same are true and correct. So help me God.

(Signature) J. E. Tuttle
J. E. Tuttle, Division Exploitation Engineer
1845 Sherman Street, Denver 3, Colorado
(Address)

SUBSCRIBED AND SWORN TO before me this 24th day of April, 1961

My commission expires September 15, 1962

Donna M. Mastain
Notary Public.

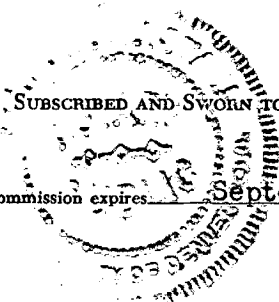

SHELL-J. L. RUMSEY #25
 SE SE NE Section 23-11S-17W
 Bemis-Shutts Field
 Ellis County, Kansas

Casing Record

13" cem 133 with 125 sx
 8 5/8" cem 1145 with 315 sx
 4 1/2" cem 3422 with 100 sx

0 - 111 clay, shale & shells
 140 shale
 468 shale & shells
 572 red bed
 635 sand
 718 shale & shells
 788 sand
 895 shale & lime shells
 1068 shale & shells
 1138 shale & lime
 1172 anhydrite
 1306 shale
 1430 shale & lime
 1670 salt & shale
 1798 shale & shells
 1809 shale
 1822 lime
 1845 shale
 1885 broken lime
 2044 lime & shale
 2140 shale & lime
 2183 shale & anhydrite
 2212 lime & shale
 2565 shale & lime SLC
 2735 shale
 2809 shale & lime
 2836 shale
 2863 lime & shale
 3022 lime
 3153 shale & lime
 3381 lime
 3401 conglomerate
 3425 dolomite
 3431 dolomite, trace chert,
 quartz grains & argillite T.D.

RECEIVED
 STATE CONSERVATION COMMISSION

APR 27 1961

CONSERVATION DIVISION
 Wichita, Kansas

04-27-61