

Give All Information Completely
Make Required Affidavit
Mail or Deliver Report to:
Conservation Division
State Corporation Commission
111 No. Broadway
Wichita, Kansas


WELL PLUGGING RECORD

15-185-12015-0000

STAFFORD County. Sec. 33 Twp. 24S Rge. 13W (E) (W)

Location as "NE/CNW/SW" or footage from lines APPROX. NW SW
Lease Owner PETROLEUM, INC.
Lease Name RUSSELL "J" M Well No. 1
Office Address ROUTE 2, GREAT BEND, KANSAS
Character of Well (completed as Oil, Gas or Dry Hole) DRY HOLE
Date well completed MARCH 20, 1962
Application for plugging filed MARCH 20, 1962
Application for plugging approved MARCH 20, 1962
Plugging commenced MARCH 20, 1962
Plugging completed MARCH 20, 1962
Reason for abandonment of well or producing formation NO PRODUCIBLE ZONES

NORTH

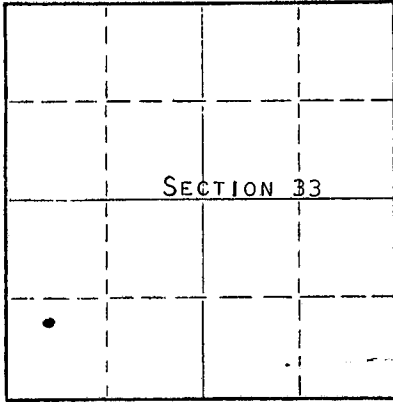

Locate well correctly on above Section Plat

If a producing well is abandoned, date of last production NONE 19
Was permission obtained from the Conservation Division or its agents before plugging was commenced? YES

Name of Conservation Agent who supervised plugging of this well W. L. LACKAMP, JR.
Producing formation _____ Depth to top _____ Bottom _____ Total Depth of Well 4258 Feet
Show depth and thickness of all water, oil and gas formations.

OIL, GAS OR WATER RECORDS

CASING RECORD

FORMATION	CONTENT	FROM	TO	SIZE	PUT IN	PULLED OUT
				8-5/8"	275'	NONE

Describe in detail the manner in which the well was plugged, indicating where the mud fluid was placed and the method or methods used in introducing it into the hole. If cement or other plugs were used, state the character of same and depth placed, from _____ feet to _____ feet for each plug set.

MUDDED UP WITH HEAVY MUD TO 240' FOLLOWED BY WOODEN PLUG, 1/4 SACK OF HULLS.
PLACED 20 SACKS CEMENT THROUGH DRILL PIPE ONTO HULLS. MUDDED UP WITH
HEAVY MUD TO 35' FOLLOWED BY WOODEN PLUG, 1/4 SACK HULLS AND 8 SACKS CEMENT
TO BASE OF WELL CELLAR.

RECEIVED
STATE CORPORATION COMMISSION

APR 9 1962

CONSERVATION DIVISION

(If additional description is necessary, use BACK of this sheet)

Name of Plugging Contractor GARVEY DRILLING COMPANY
Address ROUTE 2, GREAT BEND, KANSAS

STATE OF KANSAS, COUNTY OF BARTON, ss.
DON SEARLE (employee of owner) or (XXXXXX XXXXXX) of the above-described well, being first duly sworn on oath, says: That I have knowledge of the facts, statements, and matters herein contained and the log of the above-described well as filed and that the same are true and correct. So help me God.

(Signature) Don Searle
ROUTE 2, GREAT BEND, KANSAS
(Address)

SUBSCRIBED AND SWORN to before me this 5TH day of APRIL 1962

My commission expires APRIL 14, 1963. Charles J. White Notary Public.

WELL LOG

15-185-1205-0000

COMPANY PETROLEUM, INCORPORATED

SEC. 33 T24S R. 13W

FARM RUSSELL "I" NO. 1


LOC. Approx. NW, SW, SW

TOTAL DEPTH 4258'

COUNTY STAFFORD CO., KANSAS

COMM. March 10, 1962 COMP. March 20, 1962

CONTRACTOR GARVEY DRILLING COMPANY

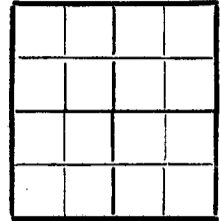

CASING 8-5/8" @ 275' w/255 sax.

ELEVATION 1946' DF

PRODUCTION D & A

FIGURES INDICATE BOTTOM OF FORMATIONS

150	Surface soil & sand
275	Shale
822	Shale & red bed
865	Anhydrite
1550	Shale
1700	Shale & lime
2965	Lime & shale
3190	Shale & lime
3350	Lime
3424	Lime & shale
3650	Shale & lime
3980	Lime
4098	Lime & chert
4149	Chert & lime
4179	Lime
4215	Cherty lime
4243	Sand & shale
4258	Lime
4258	T. D.

RECEIVED
STATE COMMISSION
APR 9 1962
CONSERVATION DIVISION

State of KANSAS }
County of BARTON } ss

I, VERNE A. MORRIS of GARVEY DRILLING COMPANY

upon oath state the above and foregoing is a true and correct copy of the log of the #1 RUSSELL "I" well.

Subscribed and sworn to before me this 28th day of March 1962

My Commission Expires: April 14, 1963

Verne A. Morris
Arthur J. Miles
NOTARY PUBLIC