


15009-06978-00-00

KANSAS
STATE CORPORATION COMMISSION

Give All Information Completely
Make Required Affidavit
Mail or Deliver Report to:
Conservation Division
State Corporation Commission
2117 W. Broadway
Wichita, Kansas

WELL PLUGGING RECORD

Barton County, Sec. 16 Twp. 20S Rge. (E) 15 (W)
 Location as "NE/CNW/SW" or footage from lines 660' S of N & 610' E of W
 Lease Owner Kansas-Nebraska Natural Gas Company, Inc.
 Lease Name Adolph Storage Well No. 3
 Office Address 300 North St. Joseph, Hastings, Nebraska
 Character of Well (completed as Oil, Gas or Dry Hole) Dry Hole
 Date well completed January 11, 19 61
 Application for plugging filed _____ 19 _____
 Application for plugging approved _____ 19 _____
 Plugging commenced January 12, 19 61
 Plugging completed January 12, 19 61
 Reason for abandonment of well or producing formation None productive formation
 If a producing well is abandoned, date of last production _____ 19 _____
 Was permission obtained from the Conservation Division or its agents before plugging was commenced? yes

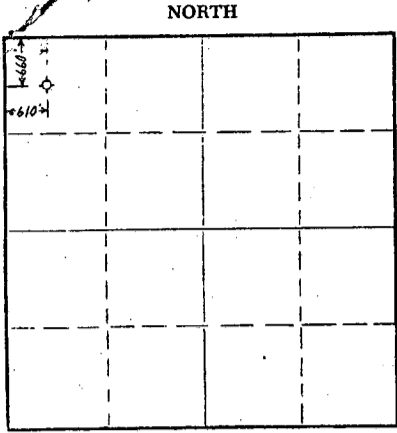

Locate well correctly on above Section Plat

Name of Conservation Agent who supervised plugging of this well Don Truan Russell, Kansas
 Producing formation Arbuckle Depth to top _____ Bottom _____ Total Depth of Well 3835 Feet
 Show depth and thickness of all water, oil and gas formations.

OIL, GAS OR WATER RECORDS

CASING RECORD

FORMATION	CONTENT	FROM	TO	SIZE	PUT IN	PULLED OUT
		0	1046	8 5/8"	1046	none

Describe in detail the manner in which the well was plugged, indicating where the mud fluid was placed and the method or methods used in introducing it into the hole. If cement or other plugs were used, state the character of same and depth placed, from _____ feet to _____ feet for each plug set.

At 3809 TD well is 77' below estimated top of Arbuckle w/o finding Arbuckle. Cemented back from 3809 with 500 cu. ft. pozmix. Top cement at 2500. Plugged back with 125 sacks. Cemented back to 2350. Drilled out cement to 2405'. Set whip stock #1 at 2405 - 1° N - 15° W. Set whip stock #2 at 2517. Set whip stock #3 at 2891. Bottom of hole 279' East and 4 1/2' south of surface location.

Plugged by Halliburton Co. with 100 sacks cement through drill pipe at 3825. Top of plug estimated at 3525'. Filled hole with mud to 410'. Bridge hole at 420', 30 sacks cement through drill pipe at 420'. Top of plug at 330'. Filled hole with mud to 30'. Top plug 10 sacks - 30' to bottom of cellar. Mud had 43 viscosity, weight 9.7#/gal. 7 cc water in 30 min.

RECEIVED
STATE CORPORATION COMMISSION


JAN 30 1961
1-30-61
CONSERVATION DIVISION
Wichita, Kansas

(If additional description is necessary, use BACK of this sheet)

Name of Plugging Contractor Bennett and Roberts Drilling Co.
 Address Russell, Kansas

STATE OF NEBRASKA COUNTY OF ADAMS ss.
 _____ (employee of owner) or (owner or operator) of the above-described well, being first duly sworn on oath, says: That I have knowledge of the facts, statements, and matters herein contained and the log of the above-described well as filed and that the same are true and correct. So help me God.

(Signature) S. D. Ford, Jr.
300 N. St. Joseph, Hastings, Nebraska (Address)

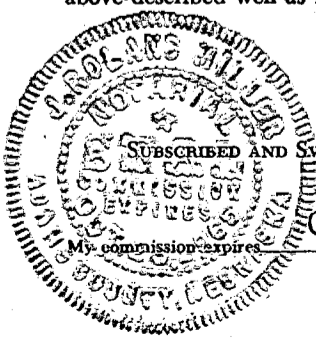

SUBSCRIBED AND SWORN TO before me this 27th day of January, 1961

October 23, 1965

J. ROLAND MILLER Notary Public.