

15-015-40193-00-0

STATE OF KANSAS
STATE CORPORATION COMMISSION

WELL PLUGGING RECORD


Give All Information Completely
Make Required Affidavit
Mail or Deliver Report to:
Conservation Division
State Corporation Commission
500 Bitting Building
Wichita, Kansas

OR

Strike out upper line
when reporting plug-
ging off formations.

FORMATION PLUGGING RECORD

Butler County. Sec. 13 Twp. 29S Rge. 5 (E) ~~XXXXX~~
Location as "NE $\frac{1}{4}$ NW $\frac{1}{4}$ SW $\frac{1}{4}$ " or footage from lines. E $\frac{1}{2}$ SW $\frac{1}{4}$ SE $\frac{1}{4}$
Lease Owner. W. C. McBride, Inc., Derby Oil Co., & E. K. Carey
Lease Name. M. Haver Well No. 6
Office Address. 2101 Missouri Pacific Building, St. Louis 3, Missouri
Character of Well (completed as Oil, Gas or Dry Hole) Dry Hole
Date well completed. January 8, 19 48
Application for plugging filed. January 7, 19 48
Application for plugging approved. January 8, 19 48
Plugging commenced. February 15, 19 48
Plugging completed. February 21, 19 48
Reason for abandonment of well or producing formation.

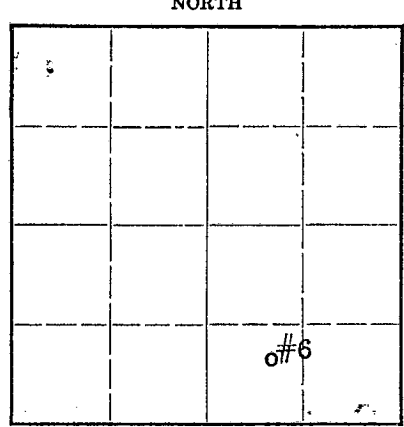

Locate well correctly on above
Section Plat

If a producing well is abandoned, date of last production. 19...
Was permission obtained from the Conservation Division or its agents before plugging was com-
menced? Yes.

Name of Conservation Agent who supervised plugging of this well. A. K. Lowman
Producing formation. Depth to top. Bottom. Total Depth of Well. Feet
Show depth and thickness of all water, oil and gas formations.


OIL, GAS OR WATER RECORDS .

CASING RECORD

Formation	Content	From	To	Size	Put In	Pulled Out
Bartlesville Sand	Dry	2817'	2851'	10"	105'	None.
Mississippi Lime	Dry	2851'	2853'	7"	2812'	2882'.

Describe in detail the manner in which the well was plugged, indicating where the mud fluid was placed and the method or methods used in introducing it into the hold. If cement or other plugs were used, state the character of same and depth placed, from...feet to...feet for each plug set.

2853' to 2800' Filled with mud. Bridged 2800' to 2790'. Dumped 2 sacks of calseal 2790' to 2781'. Cement 2781' to 2770'. Mud 2770' to 200'. Bridge 200'. 10 Sacks Cement 200' to 170'. Mud 170' to 15'. Cement 15' to Base of cellar, 5 sacks.

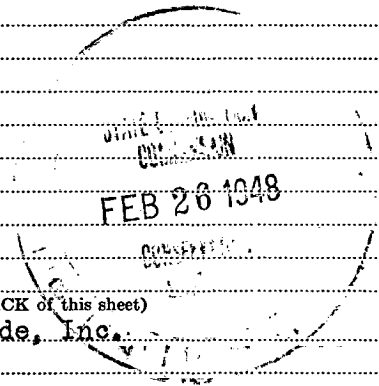

(If additional description is necessary, use BACK of this sheet)
Correspondence regarding this well should be addressed to... W. C. McBride, Inc.
Address. Box 433, McPherson, Kansas

STATE OF KANSAS, COUNTY OF MCPHERSON, ss.
FRANK ZIMMERMAN (employee of owner) or (owner or operator) of the above-described well,
being first duly sworn on oath, says: That I have knowledge of the facts, statements, and matters herein contained and the log of the above-described well as filed and that the same are true and correct. So help me God.


(Signature) *Frank Zimmerman*

Box 433, McPherson, Kansas (Address)



SUBSCRIBED AND SWORN to before me this 25th day of February, 19 48
My commission expires July 15, 1951

21-6858-RS 2-47-6M

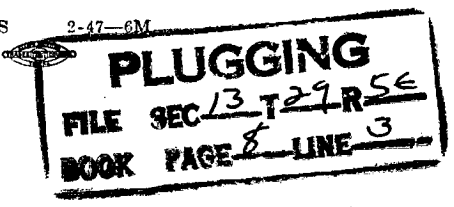

FURTHER HISTORY

Gravity of oil.....at.....Temperature.

Rig contractor.....Address.....

Rig commenced.....Completed.....

Remarks.....

Total cost of well:.....

Estimated salvage to be expected when plugged:.....

Total return well must make to pay out:.....

FORMATION RECORD

(Note: Whether Electrical Log was made.)

Depth from	To	Feet	Formation
0	105		Lime Shells
105	465		Lime Shells
465	580		Lime
580	1020		Shale & Shells
1020	1200		Shal e
1200	2184		Shale & Shells
2184	2368		Lime
2368	2805		Shale & Lime
2805	2817		Sandy Shale
2817	2851		Bartlesville Sand
2851	2853		Mississippi Lime
2853			T.D.

