


Give All Information Completely
Make Required Affidavit
Mail or Deliver Report to:
Conservation Division
State Corporation Commission
212 North Market, Insurance Bldg.
Wichita, Kansas

WELL PLUGGING RECORD

NORTH

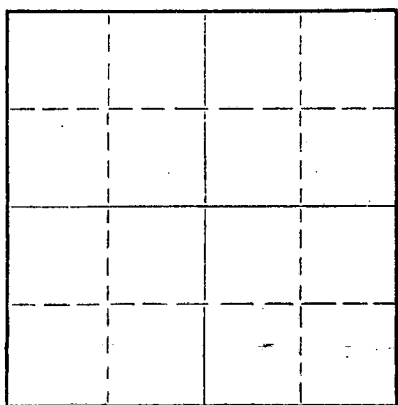

Locate well correctly on above
Section Plat

Ellis County. Sec. 23 Twp. 11 Rge. 17 E/X (W)
Location as "NE/CNW%SW%" or footage from lines 330' S 1090' W E/4 Corner
Lease Owner Cities Service Oil Company
Lease Name Rumsey Well No. 11
Office Address Box 553 - Russell, Kansas
Character of Well (completed as Oil, Gas or Dry Hole) Oil Well
Date well completed 7-12 19 39
Application for plugging filed 7-12 19 60
Application for plugging approved 7-13 19 60
Plugging commenced 8-2 19 60
Plugging completed 8-2 19 60
Reason for abandonment of well or producing formation Non-Commercial

If a producing well is abandoned, date of last production July 1960
Was permission obtained from the Conservation Division or its agents before plugging was commenced? Yes

Name of Conservation Agent who supervised plugging of this well J. Lewis Brock
Producing formation Arbuckle Depth to top _____ Bottom _____ Total Depth of Well 3424 Feet
Show depth and thickness of all water, oil and gas formations.

OIL, GAS OR WATER RECORDS

CASING RECORD

FORMATION	CONTENT	FROM	TO	SIZE	PUT IN	PULLED OUT
				5 1/2	3448'	588'
				8 5/8	998'	0

Describe in detail the manner in which the well was plugged, indicating where the mud fluid was placed and the method or methods used in introducing it into the hole. If cement or other plugs were used, state the character of same and depth placed, from _____ feet to _____ feet for each plug set.

Dumped 5 sacks cement - filled up 3424' T.D. to 3394'
Pulled 588' of 5 1/2" Casing
Circulated 30 sacks of mud thru drill pipe at 450';
Hole filled w/heavy mud to 170'
Spotted 20 sacks cement through drill pipe at 170'
Hole filled with heavy mud to 40'
Filled hole w/10 sacks cement from 40' to base of cellar.
Finished P&A 5:00 P.M. 8/2/60

RECEIVED
STATE CORPORATION COMMISSION
AUG 9 1960
CONSERVATION DIVISION
Wichita, Kansas

(If additional description is necessary, use BACK of this sheet)

Name of Plugging Contractor Shull Casing Pulling Co.
Address Great Bend, Kansas

STATE OF Kansas COUNTY OF Barton, ss:
M. M. Hardin (employee of owner) or (~~owner or operator~~) of the above-described well, being first duly sworn on oath, says: That I have knowledge of the facts, statements, and matters herein contained and the log of the above-described well as filed and that the same are true and correct. So help me God.

(Signature) M. M. Hardin

P. O. Box 553 - Russell, Kansas
(Address)

SUBSCRIBED AND SWORN TO before me this 8th day of August, 1960

My commission expires March 14, 1963
N. D. Smith
Notary Public.

10
DRILLER'S LOG

15-051-03394-0000

Well Owner: Cities Service Oil Company
 Farm Name: Rumsey Well No. 11
 Commenced: 8-2-60
 Completed: 8-2-60
 Total Depth: 3424'
 Casing: 5 1/2" Cemented @ 3448'
 8 5/8" Cemented @ 998'

330'S 1090'W E/4 Corner
 Sec. 23-11-17W

Ellis County, Kansas

Elevation: 1954

Contractor: Shull Casing Pulling Company

Production:

FIGURES BELOW INDICATE BOTTOMS OF FORMATIONS:

Shale	-0-	10
Shale and Shells		635
Shale and Shells		895
Red Beds and Shale		965
Shale		988
Shale and Shells		1087
Red Beds		1150
Lime		1187
Red Beds		1203
Red Beds and Shale		1270
Shale and Shells		1510
Salt and Shale		1620
Shale and Shells		1642
Shale and Shells		1805
Broken Lime		1941
Lime		1978
Lime and Shale		2068
Lime		2093
Shale		2264
Lime		2354
Shale		2395
Lime		2400
Shale and Shells		2663
Lime and Shale		2764
Lime and Shale		2883
Broken Lime		2927
Lime		3015
Lime		3060
Chert		3072
Broken Lime		3124
Lime		3235
Lime		3323
Lime		3386
Shale and Lime		3405
Shale and Broken Lime		3424
Total Depth		3424

RECEIVED
 STATE CORPORATION COMMISSION

AUG 9 1960

CONSERVATION DIVISION
 State of Kansas