


WELL PLUGGING RECORD

Give All Information Completely
Make Required Affidavit
Mail or Deliver Report to:
Conservation Division
State Corporation Commission
800 Biting Building
Wichita, Kansas

Ellis County, Sec. 23 Twp. 11S Rge. (E) 17(W)

Location as "NE/CNW/SW" or footage from lines NW/NE/NW/1
Lease Owner Shell Oil Company
Lease Name J. L. Rumsey Well No. 9
Office Address Box 744, Great Bend, Kansas
Character of Well (completed as Oil, Gas or Dry Hole) Oil
Date well completed Sept. 3, 19 38
Application for plugging filed April 9, 19 59
Application for plugging approved April 10, 19 59
Plugging commenced April 16, 19 59
Plugging completed April 24, 19 59
Reason for abandonment of well or producing formation Oil Depleted

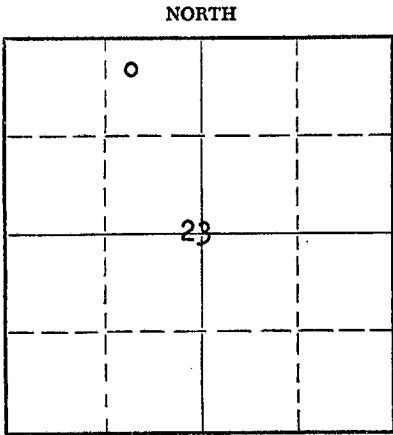

Locate well correctly on above Section Plat

If a producing well is abandoned, date of last production November 8, 1959
Was permission obtained from the Conservation Division or its agents before plugging was commenced? Yes

Name of Conservation Agent who supervised plugging of this well Mr. Eldon Petty
Producing formation Arbuckle Depth to top 3357 Bottom — Total Depth of Well 3368 Feet
Show depth and thickness of all water, oil and gas formations.

OIL, GAS OR WATER RECORDS

CASING RECORD

FORMATION	CONTENT	FROM	TO	SIZE	PUT IN	PULLED OUT
Arbuckle	I.P. 2729 BO,	3358	3368	16"	134'	
	no wtr.			10-3/4"	1092'	
				7"	3358'	2039'

Describe in detail the manner in which the well was plugged, indicating where the mud fluid was placed and the method or methods used in introducing it into the hole. If cement or other plugs were used, state the character of same and depth placed, from _____ feet to _____ feet for each plug set.

Filled hole with sand to 3361 and dumped 5 sacks of cement to 3337. Mudded to 450 and dumped 30 sacks of cement to 392. Mudded to 160' and dumped 30 sacks of cement to 102. Mudded to 30, set rock bridge to 20 and mixed 10 sacks of cement to base of cellar.

STAMP: MAY 14 1959 CONSERVATION DIVISION Wichita, Kansas

(If additional description is necessary, use BACK of this sheet)

Name of Plugging Contractor Forbes Casing Pulling Company
Address Box 221, Great Bend, Kansas

STATE OF Kansas, COUNTY OF Barton, ss. A. W. Weber (employee of owner)

well, being first duly sworn on oath, says: That I have knowledge of the facts, statements, and matters herein contained and the log of the above-described well as filed and that the same are true and correct. So help me God.

(Signature) A W Weber
Post Office Box 744, Great Bend, Kansas (Address)

SUBSCRIBED AND SWORN TO before me this 12th day of May, 1959

Signature: Lallont Byers, Jr. Notary Public.

My commission expires January 28, 1961

PLUGGING
FILE SEC. 23 T. 11 R. 17W
BOOK PAGE 39 LINE 2

Shell-J. L. Rumsey #9
 NW NE NW Section 23-11S-17W
 Bemis-Shutts Field
 Ellis County, Kansas

Casing Record

16" cem 134 with 150 sax
 10-3/4" cem 1092 with 350 sax
 7" cem 3358 with 200 sax

0 - 70 surface clay & sand
 136 " " " "
 140 sandy clay
 301 shale & shells
 310 sand & shells
 495 shale & shells
 560 sand & gravel
 816 red rock & shells
 1081 red rock
 1120 anhydrite
 1145 red bed
 1165 anhydrite
 1450 red bed & shells
 1615 salt
 1688 shale & shells
 1815 broken lime & shale
 1932 shale & shells
 2004 lime
 2040 broken lime
 2070 shale
 2130 lime
 2150 broken lime
 2180 lime
 2230 shale & shells
 2320 broken lime & shale
 2340 shale
 2362 lime
 2420 broken lime
 2665 shale & shells
 2720 lime shells & shale
 2734 shale
 2782 broken lime
 Top Topeka 2783
 2985 lime
 2995 shale
 3066 lime
 3073 shale Top Lansing-Kansas City 3098
 3103 broken lime
 3325 lime Top Sooy Conglomerate 3325
 3335 conglomerate Top Simpson 3335
 3344 dolomite, pyritic shale streaks
 3351 shale, part sandy
 3353 sand
 3357 shale Top Arbuckle Dolomite 3357
 3368 dolomite T.D.

STATE OF KANSAS
 APR 10 1959
 DIVISION OF GEOLOGY
 Kansas
 04-10-59

PLUGGING

FILE SEC. 23 T. 11 R. 17W
 BOOK PAGE 29 LINE 7

LB