


Give All Information Completely  
Make Required Affidavit  
Mail or Deliver Report to:  
Conservation Division  
State Corporation Commission  
800 Bitting Building  
Wichita, Kansas

WELL PLUGGING RECORD

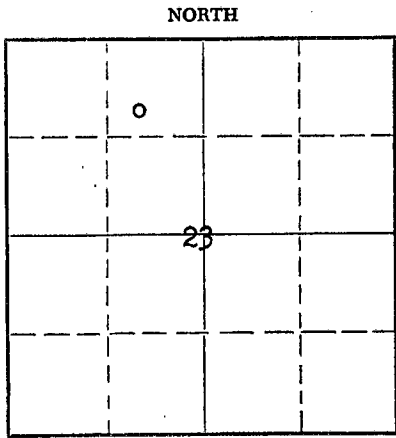

Locate well correctly on above Section Plat

Ellis County. Sec. 23 Twp. 11S Rge. 7 (17) (W)  
Location as "NE/CNW/SW" or footage from lines SW NE NW  
Lease Owner Shell Oil Company  
Lease Name J. L. RUMSEY Well No. 10  
Office Address P. O. Box 744  
Character of Well (completed as Oil, Gas or Dry Hole) Oil  
Date well completed September 16 19 58  
Application for plugging filed July 30 19 59  
Application for plugging approved July 31 19 59  
Plugging commenced October 7 19 59  
Plugging completed October 13 19 59  
Reason for abandonment of well or producing formation Oil Depleted

If a producing well is abandoned, date of last production August 11 19 59  
Was permission obtained from the Conservation Division or its agents before plugging was commenced? Yes

Name of Conservation Agent who supervised plugging of this well Eldon Petty  
Producing formation Arbuckle Depth to top 3366 Bottom \_\_\_\_\_ Total Depth of Well 3383 Feet  
Show depth and thickness of all water, oil and gas formations.

OIL, GAS OR WATER RECORDS

CASING RECORD

FORMATION	CONTENT	FROM	TO	SIZE	PUT IN	PULLED OUT
Arbuckle	I.P. 3222 BO, no wtr 24 hrs.	3367	3383	16" 10-3/4" 7"	132' 1092' 3367'	None None 2390'

Describe in detail the manner in which the well was plugged, indicating where the mud fluid was placed and the method or methods used in introducing it into the hole. If cement or other plugs were used, state the character of same and depth placed, from \_\_\_\_\_ feet to \_\_\_\_\_ feet for each plug set.

Filled hole with sand to 3350 & dumped 5 sax cement to 3326. Loaded hole with water. Pulled casing up to 800'. Pumped in 38 sacks gel mud (114 barrels) and balanced same. Pulled casing up to 500' & pumped in 30 sacks of cement to 442'; displaced cement with mud. Pulled casing up to 180' & pumped in 30 sacks of cement to 122'. Pulled remainder of casing. Mudded to 35. Set rock bridge to 25 & filled to base of cellar with 10 sacks of cement.

RECEIVED  
STATE CORPORATION COMMISSION

OCT 21 1959  
10-21-59

CONSERVATION DIVISION  
Wichita, Kansas

(If additional description is necessary, use BACK of this sheet)  
Name of Plugging Contractor Forbes Casing Pulling Company  
Address P. O. Box 221, Great Bend, Kansas

STATE OF KANSAS, COUNTY OF BARTON, ss.  
A. W. Weber (employee of owner) ~~(owner or operator)~~ of the above-described well, being first duly sworn on oath, says: That I have knowledge of the facts, statements, and matters herein contained and the log of the above-described well as filed and that the same are true and correct. So help me God.

(Signature) A. W. Weber  
P. O. Box 744, Great Bend, Kansas  
(Address)

SUBSCRIBED AND SWORN to before me this 20th day of October, 19 59  
L. Mont Byers, Jr.  
Notary Public.

My commission expires January 28, 1961  
24-7368-5 3-53-20M

SHELL-J. L. RUMSEY #10  
 SW NE NW Section 23-11S-17W  
 Bemis-Shutts Field  
 Ellis County, Kansas

Casing Record

16" cem 132 with 165 sax  
 10 3/4" cem 1092 with 150 sax LS & 200 sax Incor  
 7" cem 3367 with 200 sax

0 - 60 clay, sand & shells  
 488 shale & shells  
 600 sand  
 675 shale  
 735 sand  
 1080 red rock  
 1115 anhydrite  
 1335 red bed & shells  
 1449 red bed  
 1650 salt  
 1825 shale & shells  
 1940 lime & shale  
 2033 lime  
 2103 broken lime  
 2149 lime  
 2155 red rock  
 2175 lime  
 2310 broken lime  
 2399 shale & shells  
 2448 shale & lime shells  
 2518 lime shells & shale  
 2695 shale & shells  
 2712 broken lime  
 2770 shale & shells  
 2836 broken lime  
 3325 lime  
 3344 conglomerate  
 3353 dolomite, streaks green shale  
 3361 shale, some dolomite  
 3363 sand  
 3366 shale  
 3383 dolomite TD

Formation Tops:

Topeka 2797  
 LKC 3108  
 Sooy 3325  
 Simpson 3344  
 Arbuckle 3366

JUL 31 1959

CONSERVATION DIVISION  
 Wichita, Kansas

PLUGGING

FILE SEC. 23 T. 11 R. 17W  
 BOOK PAGE 56 LINE 17