


STATE OF KANSAS
STATE CORPORATION COMMISSION
CONSERVATION DIVISION
P. O. BOX 17027
WICHITA, KANSAS 67217

FORM CP-4

WELL PLUGGING RECORD

Ellis County, Sec. 23 Twp. 11 Rge. (E) 17 (W)

Location as "NE/CNW&SW&" or footage from lines NE NE NW
Lease Owner Thornton E. Anderson
Lease Name Rumsey Well No. 13
Office Address Suite 746 - 300 W. Douglas, Wichita, Kansas
Character of Well (completed as Oil, Gas or Dry Hole) oil 67202
Date well completed Oct. 5 1938
Application for plugging filed Dec. 24 1974
Application for plugging approved 19
Plugging commenced Jan. 14 1975
Plugging completed Jan. 22 1975
Reason for abandonment of well or producing formation depleted

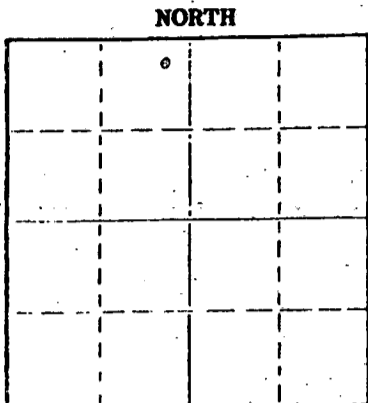

Locate well correctly on above Section Plat

If a producing well is abandoned, date of last production 19
Was permission obtained from the Conservation Division or its agents before plugging was commenced? yes

Name of Conservation Agent who supervised plugging of this well Leo Massey
Producing formation Depth to top Bottom Total Depth of Well 3380 Feet
Show depth and thickness of all water, oil and gas formations.

OIL, GAS OR WATER RECORDS

CASING RECORD

FORMATION	CONTENT	FROM	TO	SIZE	PUT IN	PULLED OUT
			1090'	10 3/4"	1090'	none
			3370'	7"	3370'	2535.47

Describe in detail the manner in which the well was plugged, indicating where the mud fluid was placed and the method or methods used in introducing it into the hole. If cement or other plugs were used, state the character of same and depth placed, from feet to feet for each plug set.

Set plug at 3350' with 30' of sand and 6 sacks of cement.

Plugged well with 9 yards of ready mix cement.

(If additional description is necessary, use BACK of this sheet)

Name of Plugging Contractor PIPE PULLERS, INC.
Address Box 128, Ellinwood, Kansas 67526

STATE OF KANSAS COUNTY OF BARTON, ss.
Evelyn Roth

(employee of owner) or (owner or operator) of the above-described well, being first duly sworn on oath, says: That I have knowledge of the facts, statements, and matters herein contained and the log of the above-described well as filed and that the same are true and correct. So help me God.

(Signature) Evelyn Roth
Ellinwood, Kansas (Address)

SUBSCRIBED AND SWORN to before me this 23 day of January 1975

My commission expires

JENNY KASSELMAN
NOTARY PUBLIC
BARTON COUNTY, KANSAS
MY COMM. EXP. JULY 16, 1978

Jenny Kasselmann
Notary Public.

RECEIVED
STATE CORPORATION COMMISSION

01-24-75
CONSERVATION DIVISION
Wichita, Kansas

15-051-05887-00-00
 WELL LOG BUREAU - KANSAS GEOLOGICAL SOCIETY,
 412 Union National Bldg, Wichita, Kansas.

COPY

SHELL PETRO. CORP.
 J.L. Rumsay No. 15.


SEC. 23 T. 11 R. 17W.
 NE 1/4
 330' N.L. 330' E.L. NW 1/4

Total Depth, 3380
 Comm. 9-16-38 Comp. 10-5-38
 Shot or Treated.
 Contractor.
 Issued. 11-12-38

County Ellis.

CASING.

16" 116'
 10 3/4" 1090
 7" 3370'

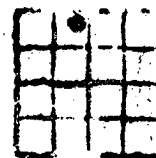

Elevation.

Production. Pot. 3391 B.
 no wtr

Figures Indicate Bottom of Formations.

sand and gravel	65
shale and shells	260
red bed & shells	495
sand and gravel	545
red rock and shalla	820
red bed and rock	1080
anhydrite	1095
anhydrite	1127
red bed and shells	1275
red bed	1325
shale and shells	1445
salt	1705
red rock and shale	1780
brokon limo	1830
shale and shells	1850
brokon limo	1960
limo	2115
brokon limo	2281
shale limo shells	2365
limo	2437
shale and shells	2498
shale	2630
limo	2670
brokon limo	2730
shale and brokon limo	2805
shale and shells	2825
limo	3040
light oil stain	
brokon limo	3070
fair oil stain	3055-68
fair oil stain	3079-87
limo	3242
limo and shale	3292
limo brokon	3333
conglomerate	3345
dolomito	3354
good oil stain	
shale	3364
sand	3365
fair porosity and stain	
shale-green	3369
dolom to	3371
fair porosity and oil show.	
dolomito	3380
Total Depth.	

RECEIVED
 STATE CORPORATION COMMISSION
 DEC 26 1974
 12-26-74
 CONSERVATION DIVISION
 Wichita, Kansas