


STATE OF KANSAS  
STATE CORPORATION COMMISSION

Form CP-4

WELL PLUGGING RECORD

Give All Information Completely  
Make Required Affidavit  
Mail or Deliver Report to:  
Conservation Division  
State Corporation Commission  
P. O. Box 17027  
Wichita, Kansas 67217  
NORTH

Ellis County, Sec. 23 Twp. 11S Rge. (E) 17 (W)  
Location as "NE/CNW&SW" or footage from lines. NW SW SE (948' FSL 2310' FEL)  
Lease Owner: Cities Service Oil Company  
Lease Name: Rumsey "A" Well No. 6  
Office Address: Box 553 Russell, Kansas 67665  
Character of Well (completed as Oil, Gas or Dry Hole): Oil  
Date well completed: 12-22 19 38  
Application for plugging filed: 11-12 19 71  
Application for plugging approved: 11-15 19 71  
Plugging commenced: 12-10 19 71  
Plugging completed: 12-29 19 71  
Reason for abandonment of well or producing formation: Depleted

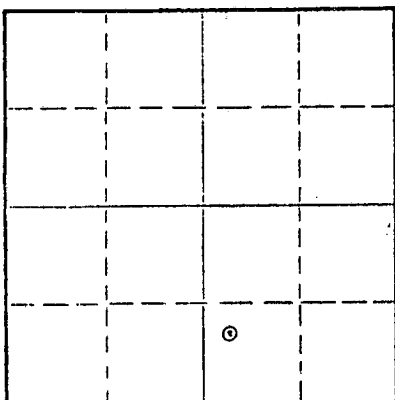

Locate well correctly on above  
Section Plat

If a producing well is abandoned, date of last production: June 19 58  
Was permission obtained from the Conservation Division or its agents before plugging was commenced? Yes

Name of Conservation Agent who supervised plugging of this well: Mr. Leo Massey  
Producing formation: Arbuckle Depth to top: 3410' Bottom: 137' Pen. Total Depth of Well: 3547 Feet  
Show depth and thickness of all water, oil and gas formations.

OIL, GAS OR WATER RECORDS

CASING RECORD

FORMATION	CONTENT	FROM	TO	SIZE	PUT IN	PULLED OUT
				10 3/4"	998'	None
				7"	3410'	1649'
		3547'	3746'	5 1/2"	199'	None

Describe in detail the manner in which the well was plugged, indicating where the mud fluid was placed and the method or methods used in introducing it into the hole. If cement or other plugs were used, state the character of same and depth placed, from \_\_\_\_\_ feet to \_\_\_\_\_ feet for each plug set.

Checked bottom, pushed plug to 3348', dumped sand 3348' to 3338', and 75x. cement 3338' to 3301'. Shot 7" casing at 2132', 1766', and 1676' and pulled 52 joints. Halliburton pumped 20 sx. gel, 100 lbs. hulls, 135 sx. cement. Mud 1050' to 450' and cement 450' to surface.


RECEIVED  
STATE CORPORATION COMMISSION  
APR 13 1972  
4-13-72  
CONSERVATION DIVISION  
Wichita, Kansas

(If additional description is necessary, use BACK of this sheet)

Name of Plugging Contractor: Knight Casing Pulling Co., Inc.  
Address: Chase, Kansas

STATE OF Kansas, COUNTY OF Russell, ss.  
E. W. Peterman (employee of owner) or (owner or operator) of the above-described well, being first duly sworn on oath, says: That I have knowledge of the facts, statements, and matters herein contained and the log of the above-described well as filed and that the same are true and correct. So help me God.

(Signature) *E. W. Peterman*  
Box 553 Russell, Kansas 67665 (Address)

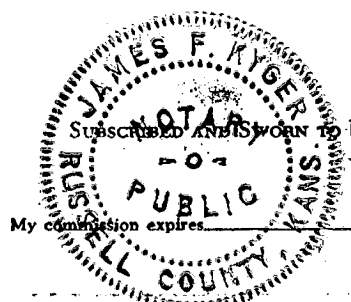

Subscribed and sworn to before me this 11th day of April, 1972

*James F. Kyger*  
Notary Public.

DEEPENING  
WELL RECORD

15-051-03389-0001

RECEIVED  
STATE CORPORATION COMMISSION  
NOV 15 1971  
CONSERVATION DIVISION  
Wichita, Kansas

WILDCAT.....

DISCOVERY.....

POOL.....

COMPANY Cities Service Oil Co. WELL # 6 FARM Rumsey

LOCATION 1692' South and 330' East of Center

Section 23, Township 11, Range 17W.

ELEV. 1950' CO. Ellis STATE Kansas

IP. None

PERFS. ....

FRAC. .... ACID 200 gals. 5-27-58

T.D. 3547' PBTD 3460' GRAV/GOR.....

DEEPENING April 17, 1958 COMP. April 21, 1958 Folger-Parker Drilg. Co.,  
ADREG COMM. April 17, 1958 CONTRACTOR Inc.

CASING RECORD:

7" at 3411' with 150 sacks cement.  
199' of 5 1/2" liner at 3547' with 70 sacks  
cement.

FORMATION RECORD:

Old T.D. 3416  
Line 3416-3547 T.D.

Top Arbuckle 3410  
Pen. 137'  
T.D. 3547

Drilled cement to 3532 SIM.  
Perf. 5 shots 3484-86.

2290' fluid (90' oil, 2200' water) in  
15 hours.

5-3-58 Pump 5 oil, 235 water, 24 hrs.  
5-11-58 Pump 3 oil, 227 water, 24 hrs.

Set plug at 3471'; 2 sacks cement on plug;  
PBTD 3460 SIM.

13 shots 3440-43.  
11 shots 3453-56.

5-27-58 Acidized 100 gals. 3440-43.  
5-27-58 Acidized 100 gals. 3453-56.

5-31-58 Pump 5 oil, 315 water, 24 hrs.  
6-2-58 Pump 3 oil, 315 water, 24 hrs.  
6-3-58 Pump 1 1/2 oil, 315 water, 24 hrs.