


STATE OF KANSAS  
STATE CORPORATION COMMISSION  
CONSERVATION DIVISION  
P. O. BOX 17027  
WICHITA, KANSAS 67217

WELL PLUGGING RECORD

Ellis County, Sec. 23 Twp. 11 Rge. (E) 17 (W)  
Location as "NE/CNW/SW" or footage from lines SW SE NW

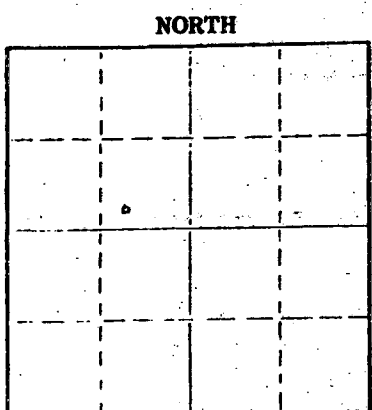

Locate well correctly on above Section Plat

Lease Owner: Thornton E. Anderson  
Lease Name: Rumsey Well No. 12  
Office Address: Suite 746 - 300 W. Douglas, Wichita, Kansas  
Character of Well (completed as Oil, Gas or Dry Hole): oil 67202  
Date well completed: Oct. 2 19 38  
Application for plugging filed: Dec. 24 19 74  
Application for plugging approved: 19  
Plugging commenced: Jan. 22 1975  
Plugging completed: Jan. 27 1975  
Reason for abandonment of well or producing formation: depleted

If a producing well is abandoned, date of last production 19  
Was permission obtained from the Conservation Division or its agents before plugging was commenced? YES

Name of Conservation Agent who supervised plugging of this well: Leo Massey  
Producing formation: Depth to top: Bottom: Total Depth of Well: 3421 Feet  
Show depth and thickness of all water, oil and gas formations.

OIL, GAS OR WATER RECORDS

CASING RECORD

FORMATION	CONTENT	FROM	TO	SIZE	PUT IN	PULLED OUT
			129'	16"	129'	none
			1095'	10 3/4"	1095'	none
			3371'	7"	3371'	2513.96

Describe in detail the manner in which the well was plugged, indicating where the mud fluid was placed and the method or methods used in introducing it into the hole. If cement or other plugs were used, state the character of same and depth placed, from feet to feet for each plug set.

Set plug at 3320' and dumped 6 sacks of cement.  
Set 20' rock bridge at 420' and plugged well with 8 yards of ready mix cement.

(If additional description is necessary, use BACK of this sheet)  
Name of Plugging Contractor: PIPE PULLERS, INC.  
Address: Box 128, Ellinwood, Kansas 67526

STATE OF KANSAS COUNTY OF BARTON ss.  
Evelyn Roth (employee of owner) or (owner or operator) of the above-described

well, being first duly sworn on oath, says: That I have knowledge of the facts, statements, and matters herein contained and the log of the above-described well as filed and that the same are true and correct. So help me God.

(Signature) Evelyn Roth  
Ellinwood, Kansas (Address)

SUBSCRIBED AND SWORN TO before me this 29th day of January, 1975

My commission expires  
JENNY KASSELMAN  
NOTARY PUBLIC  
BARTON COUNTY, KANSAS  
MY COMM. EXP. JULY 16, 1978

Jenny Kaselman  
Notary Public.

RECEIVED  
STATE CORPORATION COMMISSION  
JAN 30 1975  
CONSERVATION DIVISION  
Wichita, Kansas

15-051-05860-000

WELL LOG BUREAU - KANSAS GEOLOGICAL SOCIETY.  
412 Union National Bank Bldg, Wichita, Kansas.

SHELL PETROLEUM CORP.  
J.L. Rumsey No. 12.

SEC. 23 T. 11 R. 17W.  
SW SE NW  
330' SL. 982' EL. NW 1/4

County. Ellis.

Total Depth. 3390  
Comm. 9-10-38 Comp. 10-2-38  
Shot or Treated.  
Contractor. Corbett and Barbour.  
Issued. 11-12-38

Rotary 3372  
Cable 3390



CASING.

16" 129'  
10 3/4" 1095'  
7" 3371'

Elevation.

Production. Pot. 3321 B.

FIGURES INDICATE BOTTOM OF FORMATIONS.

surface rock shale and sand 132  
 iron broken shale 300  
 red rock shale 421  
 sand 470  
 iron shale 577  
 shale 660  
 sand 740  
 red rock 789  
 red bed 810  
 shells and sand 850  
 shale 900  
 lime shells & shale 975  
 sand and shells 1035  
 shale 1082  
 anhydrite 1100  
 anhydrite 1130  
 red bed 1360  
 shale and shells 1445  
 shale and salt 1525  
 salt 1650  
 shale and shells 1790  
 lime 1878  
 shale and shells 1970  
 lime 2133  
 broken limo 2200  
 shale 2215  
 broken limo 2240  
 shale and shells 2275  
 broken limo 2550  
 shale and shells 2600  
 broken limo 2610  
 shale 2665  
 broken limo 2804  
 limo 2908  
 limo 2955  
 short and limo 2984  
 lime 3072  
 good stain 3024-27  
 Trace oil stain 3063-73

poor oil stain 3988-97  
 good oil stain 3115-23  
 poor oil stain 3180-84  
 broken limo 3112  
 limo 3327  
 conglomerate 3349  
 dolomite 3357  
 shale groon 3364  
 sand 3366  
 fair porosity and some oil stain  
 shale groon 3370  
 3375- 3372' SL.  
 dolomite 3390

Total Depth.  
2900' oil 3372

RECEIVED  
STATE CORPORATION COMMISSION  
JUL 26 1974  
CONSERVATION DIVISION  
Wichita, Kansas