

STATE OF KANSAS
STATE CORPORATION COMMISSION


Form CP-4

Give All Information Completely
Make Required Affidavit
Mail or Deliver Report to:
Conservation Division
State Corporation Commission
P. O. Box 17027
Wichita, Kansas 67217
NORTH

WELL PLUGGING RECORD

Ellis County, Sec. 23 Twp. 11S Rge. (E) 17 (W)

Location as "NE/CNW&SW&" or footage from lines SE NW SE
Lease Owner Cities Service Oil Company
Lease Name Rumsey "A" Well No. 16
Office Address Box 553 Russell, Kansas 67665
Character of Well (completed as Oil, Gas or Dry Hole) Oil
Date well completed 1-27 1950
Application for plugging filed 7-11 1972
Application for plugging approved 7-12 1972
Plugging commenced 8-1 1972
Plugging completed 8-10-72
Reason for abandonment of well or producing formation Depleted

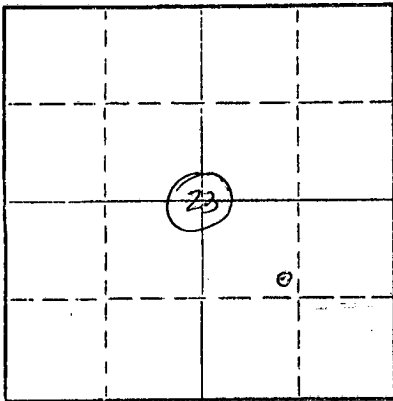

Locate well correctly on above Section Plat

If a producing well is abandoned, date of last production 2-15 1972
Was permission obtained from the Conservation Division or its agents before plugging was commenced? Yes

Name of Conservation Agent who supervised plugging of this well Mr. Leo Massey
Producing formation Arbuckle Depth to top 3459 Bottom 94' Pen Total Depth of Well 3553 Feet
Show depth and thickness of all water, oil and gas formations.

OIL, GAS OR WATER RECORDS

CASING RECORD

FORMATION	CONTENT	FROM	TO	SIZE	PUT IN	PULLED OUT
				8 5/8"	1197'	None
				5 1/2"	3553'	2517'

Describe in detail the manner in which the well was plugged, indicating where the mud fluid was placed and the method or methods used in introducing it into the hole. If cement or other plugs were used, state the character of same and depth placed, from _____ feet to _____ feet for each plug set.

Dumped sand 3553' to 3500', dumped 5 sx. cement 3500' to 3465'. Shot 5 1/2" casing at 2622' and 2525' and pulled 79 joints of 5 1/2" casing. Halliburton pumped 3 sx. hulls, 20 sx. gel 1220' to 500' and released 8 5/8" plug. Pumped 100 sx. Howco Lite cement 500' to surface. Max. 500# SIP 350# Complete at 12:40 P.M. 8-10-72.


RECEIVED
STATE CORPORATION COMMISSION
AUG 15 1972
CONSERVATION DIVISION
Wichita, Kansas

(If additional description is necessary, use BACK of this sheet)
Name of Plugging Contractor Knight Casing Pulling Co., Inc.
Address Chase, Kansas

STATE OF Kansas COUNTY OF Russell, ss.
E. W. Peterman (employee of owner) or (owner or operator) of the above-described well, being first duly sworn on oath, says: That I have knowledge of the facts, statements, and matters herein contained and the log of the above-described well as filed and that the same are true and correct. So help me God.

(Signature) *E. W. Peterman*
Box 553, Russell, Kansas 67665
(Address)

Subscribed and Sworn to before me this 14th day of August, 1972

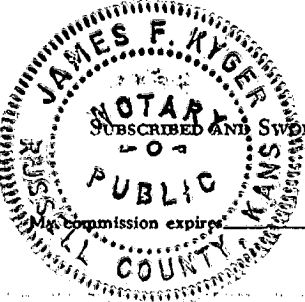

James F. Kyger
Notary Public.

10-5-72

Company Cities Service Oil Co. Well No. 16 Farm Rumsey
 Location 990' South and 990' East of Center Sec. 23 T. 11 R. 17W
 Elevation 1993 (1991 Gr.) County Ellis State Kansas
 Drlg. Comm. January 11, 1950 Contractor Holm Drilling Company
 Drlg. Comp. January 27, 1950 Acid None
 T. D. 3553' Initial Prod. Physical Potential: 167 oil, 36% water, 24 hrs. (2-27-50)
 P. D. 3537' SLM

CASING RECORD:

8-5/8" @ 1197' cem. 600 sx cem., 6' C.C. & 300# Flocele
 5-1/2" @ 3553' cem. 150 sx cement

FORMATION RECORD:

shale & shells 0-550
 sand, shale & shells 710
 shale 760
 sand 840
 shale & shells 910
 red bed & shells 1187
 anhydrite 1222
 shale & shells 1885
 lime & shale 2015
 shale & lime 2105
 lime & shale 2114
 lime 2120
 lime & shale 2465
 shale 2480
 shale & shells 2925
 shale & lime 3048
 lime 3135
 lime & chert 3170
 lime 3438
 shale 3465
 lime 3550

3550 RTD = 3553 SLM

Corr. Top Topeka 2926'
 Corr. Top Lansing 3192'
 Corr. Top Simpson 3440'
 Corr. Top Arbuckle 3459' (-1466)
 Penetration 94'
 Total Depth 3553'

Drilled cement to 3537 SLM.

Perf. 35 shots 3518-24; 65' oil in 15 mins.
 200' oil in 45 mins
 785' oil in 1-3/4 hrs.
 1500' oil in 3-3/4 hrs.
 2000' oil in 5-3/4 hrs.
 2850' oil in 19-3/4 hrs.

SYFO: 500' 1°
 1000' 1°
 1500' 1°
 2000' 1°
 2500' 1°
 3000' 1°

7-7/8" rotary hole.

RECEIVED
 STATE CORPORATION COMMISSION
 CONSERVATION DIVISION
 Wichita, Kansas
 11 12 1972 07-12-72