


STATE OF KANSAS  
STATE CORPORATION COMMISSION  
Give All Information Completely  
Make Required Affidavit  
Mail or Deliver Report to:  
Conservation Division  
State Corporation Commission  
212 North Market, Insurance Bldg.  
Wichita, Kansas

### WELL PLUGGING RECORD

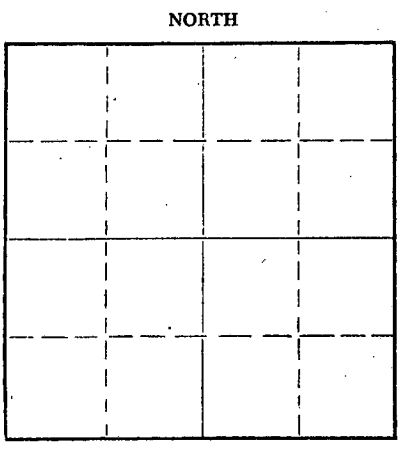

Locate well correctly on above Section Plat

Ellis County. Sec. 23 Twp. 11 Rge. 17 (E) (W)  
Location as "NE/CNW%SW%" or footage from lines 330' 330' E S/4 Corner  
Lease Owner Cities Service Oil Co.  
Lease Name Rumsey Well No. 7  
Office Address Box 553 Russell, Kansas  
Character of Well (completed as Oil, Gas or Dry Hole) Oil  
Date well completed 4-19- 1960  
Application for plugging filed 7-12- 1960  
Application for plugging approved 7-13- 1960  
Plugging commenced 8-3- 1960  
Plugging completed 8-6- 1960  
Reason for abandonment of well or producing formation Non-commercial

If a producing well is abandoned, date of last production July 19 60  
Was permission obtained from the Conservation Division or its agents before plugging was commenced? Yes

Name of Conservation Agent who supervised plugging of this well J. Lewis Brock  
Producing formation Arbuckel Depth to top 3434' Bottom 3441' Total Depth of Well 3441 Feet  
Show depth and thickness of all water, oil and gas formations.

#### OIL, GAS OR WATER RECORDS

#### CASING RECORD

FORMATION	CONTENT	FROM	TO	SIZE	PUT IN	PULLED OUT
				8 5/8"	1010'	-0-
				5 1/2"	3455'	2356'

Describe in detail the manner in which the well was plugged, indicating where the mud fluid was placed and the method or methods used in introducing it into the hole. If cement or other plugs were used, state the character of same and depth placed, from \_\_\_\_\_ feet to \_\_\_\_\_ feet for each plug set.

Run 5 sks of cement at 3441'  
Pumped 25 sks of mud in hole  
Pumped 20 sks of cement at 550'  
Pumped 20 sks of cement at 180'  
Set rock bridge to 35'  
Run 10 sks cement to cap

**RECEIVED**  
STATE CORPORATION COMMISSION  
AUG 23 1960  
08-23-60  
CONSERVATION DIVISION  
Wichita, Kansas

(If additional description is necessary, use BACK of this sheet)  
Name of Plugging Contractor Shull Casing Pulling Co.  
Address Great Bend, Kansas

STATE OF Kansas, COUNTY OF Barton, ss.  
M.M. Hardin (employee of owner) or (~~owner or operator~~) of the above-described well, being first duly sworn on oath, says: That I have knowledge of the facts, statements, and matters herein contained and the log of the above-described well as filed and that the same are true and correct. So help me God.

(Signature) M.M. Hardin  
Box 553 Russell, Kansas (Address)

SUBSCRIBED AND SWORN TO before me this 24 day of August, 1960  
W. D. Smith Notary Public.  
My commission expires March 17, 1963

R

DRILLER'S LOG

15-051-03390-0001

Well Owner: Cities Service Oil Company  
 Farm Name: Rumsey Well No. 7  
 Commenced: 8-4-60  
 Completed:  
 Total Depth: 3441'  
 Casing: 5½" Cemented @ 3435'  
 Contractor: Shull Casing Pulling Co.

330'E 330'N S/4 Corner  
 Sec. 23-11-17W  
 Ellis County, Kansas  
 Elevation: 1976  
 Production:

FIGURES BELOW INDICATE BOTTOMS OF FORMATIONS

Shale	-0-	50
Shale and Shells		350
Sand		480
Shale		530
Sand		805
Red Beds and Shale		1000
Red Beds Shale		1131
Shale and Shells		1195
Anhydrite Lime		1198
Shale		1270
Shale and Shells		1446
Shale and Shells		1520
Salt and Shale		1705
Shale and Shells		1790
Broken Lime		1844
Broken Lime		1918
Lime		1979
Broken Lime		2032
Broken Lime		2100
Lime		2175
Broken Lime		2183
Lime and Shale		2252
Lime and Shale		2328
Shale and Shells		2345
Lime		2368
Broken Lime		2394
Broken Lime		2447
Shale and Shells		2531
Shale and Shells		2560
Broken Lime		2608
Shale and Lime		2779
Lime		2830
Shale and Shells		2894
Broken Lime		2910
Lime		2949
Lime		3052
Lime and Chert		3082
Lime		3163
Broken Lime		3206
Lime		3212
Lime		3308
Lime		3413
Lime and Shale		3428
Dolemite		3439
Lime		3441
Total Depth		3441

RECEIVED  
 STATE CORPORATE COMMISSION  
 AUG 23 1960  
 CONSERVATION DIVISION