


Give All Information Completely
Make Required Affidavit
Mail or Deliver Report to:
Conservation Division
State Corporation Commission
212 No. Market
Wichita, Kansas

WELL PLUGGING RECORD

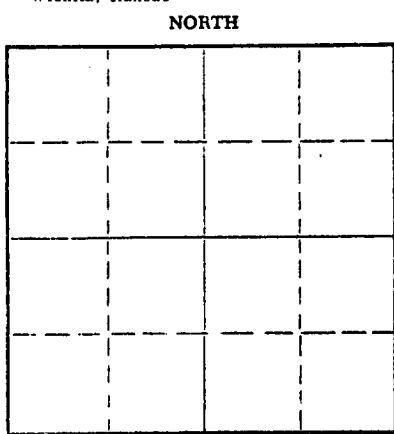

Locate well correctly on above Section Plat

Ellis County. Sec. 22 Twp 11 Rge. (E) 17 (W)
Location as "NE/CNW/SW" or footage from lines SW/4 NE/4 NW/4
Lease Owner Ormand Industries
Lease Name Bemis "A" Well No. 8
Office Address 2118 Adolphus Tower, Dallas, Texas
Character of Well (completed as Oil, Gas or Dry Hole) oil
Date well completed July 22 1956
Application for plugging filed 19
Application for plugging approved 19
Plugging commenced 4/26/69 19
Plugging completed 5/3/69 19
Reason for abandonment of well or producing formation depleted.
If a producing well is abandoned, date of last production 19
Was permission obtained from the Conservation Division or its agents before plugging was commenced? yes

Name of Conservation Agent who supervised plugging of this well Massey
Producing formation Arbuckle Depth to top 3417 Bottom 3471 Total Depth of Well 3471 Feet
Show depth and thickness of all water, oil and gas formations.

OIL, GAS OR WATER RECORDS

CASING RECORD

FORMATION	CONTENT	FROM	TO	SIZE	PUT IN	PULLED OUT
Arbuckle	oil	3417	3471	10-3/4"	1137	none
				7"	3500'	1427'

Describe in detail the manner in which the well was plugged, indicating where the mud fluid was placed and the method or methods used in introducing it into the hole. If cement or other plugs were used, state the character of same and depth placed, from feet to feet for each plug set.

Checked bottom, had bridge at 1409', ran sand to 3460' and dumped 7 sacks of cement. Shot pipe at 1517', 1430', pulled 49 joints. Allied plugged well with 160 sacks of cement, 30 sacks gel and 5 sacks hulls.

PLUGGING COMPLETE.

RECEIVED
STATE CORPORATION COMMISSION
MAY 20 1969
CONSERVATION DIVISION
Wichita, Kansas

(If additional description is necessary, use BACK of this sheet)
Name of Plugging Contractor KNIGHT CASING PULLING CO., INC.
Address CHASE, KANSAS

STATE OF KANSAS, COUNTY OF RICE, ss.
NOEL J. KNIGHT (employee of owner) or (owner or operator) of the above-described well, being first duly sworn on oath, says: That I have knowledge of the facts, statements, and matters herein contained and the log of the above-described well as filed and that the same are true and correct. So help me God.

(Signature) Noel Knight
CHASE, KANSAS
(Address)

Subscribed AND SWORN TO before me this 6th day of May 19 69

Margaret Melcher
Notary Public.

My commission expires 2/15/71

BEMIS A - 8

SW NE NW 22-11-17W
Ellis County, Kansas

15-051-05109-0000

Surface	0 - 40
Shale & sand strks	40 - 590
Sand & pyrite	590 - 640
Sand & shoal	640 - 1140
Anhydrite	1140 - 1175
Red bed	1175 - 1792
Red bed, shale & shells	1792 - 2033
Shale & lime shells	2033 - 2140
Lime & shale	2140 - 2425
Shale & lime	2425 - 2850
Lime & shale	2850 - 3060
Lime	3060 - 3110
Lime & shale	3110 - 3170
Lime	3170 - 3500

RECEIVED
STATE CORPORATION COMMISSION
FEB 18 1969
CONSERVATION DIVISION
Wichita, Kansas