


WELL PLUGGING RECORD

Give All Information Completely
Make Required Affidavit
Mail or Deliver Report to:
Conservation Division
State Corporation Commission
211 No. Broadway
Wichita, Kansas

Ellis County. Sec. 22 Twp. 11 Rge. (E) 17 (W)

Location as "NE/CNW/SW" or footage from lines SW SE SW
Lease Owner Sohio Petroleum Company
Lease Name Bemis "C" Well No. 4
Office Address Box 673, Russell, Kansas
Character of Well (completed as Oil, Gas or Dry Hole) Oil
Date well completed 6-8 1937
Application for plugging filed 2-7 1959
Application for plugging approved 2-9 1959
Plugging commenced 3-11 1959
Plugging completed 3-14 1959
Reason for abandonment of well or producing formation Uneconomical

NORTH

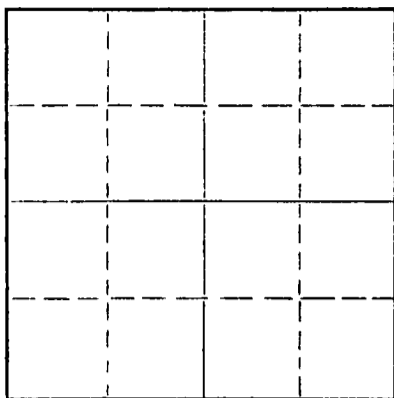

Locate well correctly on above
Section Plat

If a producing well is abandoned, date of last production December 1957
Was permission obtained from the Conservation Division or its agents before plugging was commenced? YES

Name of Conservation Agent who supervised plugging of this well Eldon Petty
Producing formation Arbuckle Depth to top _____ Bottom _____ Total Depth of Well 3534 1/2 Feet
Show depth and thickness of all water, oil and gas formations.

OIL, GAS OR WATER RECORDS

CASING RECORD

FORMATION	CONTENT	FROM	TO	SIZE	PUT IN	PULLED OUT
Arbuckle				7"	3518'	2533'

Describe in detail the manner in which the well was plugged, indicating where the mud fluid was placed and the method or methods used in introducing it into the hole. If cement or other plugs were used, state the character of same and depth placed, from _____ feet to _____ feet for each plug set.

Dumped 40 gallons sand. Fillup 8'. Dumped 30 gallons sand to 3500'.
Dumped 5 sacks cement on top. Pulled casing to 550'. Circulated
using 22 sacks mud. Spotted 30 sacks cement. Pulled casing to 180'
and spotted 30 sacks cement. Pulled casing, set 5' rock bridge and
dumped 10 sacks cement to bottom of cellar.

RECEIVED
STAT CORP COM

MAR 18 1959

C. DIVISION

(If additional description is necessary, use BACK of this sheet)

Name of Plugging Contractor West Supply Company
Address Chase, Kansas

STATE OF Kansas, COUNTY OF Russell, ss.
J. H. Bond (employee of owner) of the above-described
well, being first duly sworn on oath, says: That I have knowledge of the facts, statements, and matters herein contained and the log of the
above-described well as filed and that the same are true and correct. So help me God.

(Signature) J. H. Bond
(Address) _____

SUBSCRIBED AND SWORN TO before me this 17th day of March, 1959

My commission expires March 31, 1961

Margaret Lee Newman
Notary Public.



PLUGGING
FILE SEC. 22 T. 11 R. 17W
BOOK PAGE 14 LINE 36

15-051-05832-0000

LOG OF MARGAY OIL CORPORATION

Section 22-113-117, R17W, T14N, E12E, Township, Kansas

Completion Date: 5-6-37
 Completion Depth: 6-8-37

FROM	TO	FORMATION	FROM	TO	FORMATION
0	10	Collar	2410	2445	Shale, sticky
10	20	Lime stone	2445	2504	Lime & shale
20	20	Shale, shells & clay	2504	2540	Lime
Set & cemented surface casing			2540	2587	Lime & shale
20	644	Shale & shells	2587	2645	Grey shale, sticky
644	664	Sand	2645	2698	Shale & shells
664	788	Shale & shells	2698	2800	Shale & shells
788	840	Black, hard, sand & lime	2800	2854	Shale & shells
840	900	Soft white water sand	2854	2945	Shale & shells
900	900	Red rock & shale	2945	2945	Shale & shells
900	1118	Sticky shale & shells	2945	2945	Shale
1118	1150	Shale & shells	2945	2978	Lime
1150	1178	Hard & soft sand	2978	2978	Shale & shells
1178	1200	Shale & shells	2978	3020	Lime, hard
1200	1207	Dark blue shale, pyrites	3020	3020	Lime
1207	1275	Anhydrite	3020	3084	S. L. M. Correction
1275	1275	S. L. M. Correction	3084	3107	Lime
Set & cemented 18" casing with 300 sacks cement			3107	3120	Lime & broken lime
1275	1295	Anhydrite	3120	3173	Lime & shale & sand
1295	1300	Anhydrite & shale	3173	3173	Blue shale
1300	1378	Anhydrite	3173	3226	Lime
1378	1405	Shale & shells	3226	3312	Lime & shale
1405	1400	Red rock, shale & shells	3312	3370	Broken lime
1400	1510	Anhydrite	3370	3381	Shale
1510	1540	Red rock, shale & shells	3381	3393	hard white lime
1540	1580	Lime shells	3393	3410	Broken lime
1580	1607	Shale & shells	3410	3420	Hard lime
1607	1600	Anhydrite & lime	3420	3457	Broken lime
1600	1605	Lime & shale	3457	3461	Lime
1605	2000	Lime & shale	3461	3485	Lime & shale
2000	2071	Hard lime shells	3485	3501	Lime
2071	2145	Lime & shale	3501	3517	Lime & sand
2145	2100	Lime & shale, red rock	3517	3521	Lime
2100	2307	Lime & shale	3521	3518	S. L. M. Correction
2307	2343	White lime, medium hard	Set & cemented 7" O. D. casing with 100 sacks cement		
2343	2375	Soft white lime	3518	3525	Standard load measurement
2375	2385	White lime, medium hard	3525	3554	Silicious lime
2385	2410	S. L. M. Correction	3554	3554	Lime

RECEIVED
 STATE CORPORATION COMMISSION

FEB 6 1937

CONSERVATION DIVISION
 Wichita, Kansas

PLUGGING
 FILE SEC 22 T 11 R 17W
 BOOK PAGE 14 LINE 36