


WELL PLUGGING RECORD

Give All Information Completely
Make Required Affidavit
Mail or Deliver Report to:
Conservation Division
State Corporation Commission
211 No. Broadway
Wichita, Kansas

Ellis County. Sec. 22 Twp. 11 Rge. (E) 17 (W)
Location as "NE/CNW&SW" or footage from lines SE SE SW
Lease Owner Sohio Petroleum Company
Lease Name Demis "C" Well No. 5
Office Address Russell, Kansas
Character of Well (completed as Oil, Gas or Dry Hole) oil
Date well completed 6-2 1956
Application for plugging filed 12-6 1956
Application for plugging approved 12-7 1956
Plugging commenced 12-27 1956
Plugging completed 12-28 1956
Reason for abandonment of well or producing formation Uneconomical

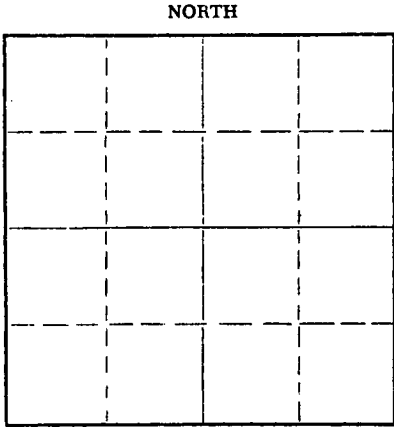

Locate well correctly on above Section Plat

If a producing well is abandoned, date of last production June 1954
Was permission obtained from the Conservation Division or its agents before plugging was commenced? Yes

Name of Conservation Agent who supervised plugging of this well Eldon Petty
Producing formation _____ Depth to top _____ Bottom _____ Total Depth of Well 3162 Feet
Show depth and thickness of all water, oil and gas formations.

OIL, GAS OR WATER RECORDS

CASING RECORD

FORMATION	CONTENT	FROM	TO	SIZE	PUT IN	PULLED OUT
				10-3/4	1202'	None
				7"	3150'	1779'

Describe in detail the manner in which the well was plugged, indicating where the mud fluid was placed and the method or methods used in introducing it into the hole. If cement or other plugs were used, state the character of same and depth placed, from _____ feet to _____ feet for each plug set.

3150' to 300' - Heavy mud - 30 sacks jel
300' to 45' - Rock Bridge and 30 sacks cement and mud
45' to cellar - Rock Bridge and 20 sacks cement and mud

(If additional description is necessary, use BACK of this sheet)

Name of Plugging Contractor West Supply Company
Address Chase, Kansas

STATE OF Kansas, COUNTY OF Russell, ss.
J. H. Bond (employee of owner) or former operator of the above-described well, being first duly sworn on oath, says: That I have knowledge of the facts, statements, and matters herein contained and the log of the above-described well as filed and that the same are true and correct. So help me God.

(Signature) J. H. Bond
(Address)

SUBSCRIBED AND SWORN TO before me this 31 day of December, 1956

Dereck B. Brown
Notary Public.

My commission expires January 24, 1959

PLUGGING
FILE NO. 22 T. 11. R. 17. W.
BOOK PAGE 123 LINE 23



01-02-57

15-051-05833-0000

LOG OF MARGAY OIL CORPORATION
Section 22-11S-17W, Ellis County, Kansas

BEMIS C-5

Commenced: 5-8-37
Completed: 6-2-37

FROM	TO	FORMATION
0	25	Clay
25	37	Shale & shells
Set & cemented surface casing		
37	108	Shale
108	564	Shale & shells
564	628	Sand
628	644	Iron pyrites, broken
644	719	Shale & shells
719	731	Broken pyrites of iron
731	762	Shale & shells
762	847	Sand
847	869	Shale & shells
869	935	Sticky shale
935	953	Red bed
953	1183	Red beds & sticky shale
1183	1190	Sticky red shale
1190	1195	White chalk
1195	1202	Anhydrite
Set & cemented 10" O.D. casing with 350 sacks cement		
1202	1231	Anhydrite
1231	1319	Red shale & anhydrite
1319	1502	Red shale & shells
1502	1769	Shale & shells
1769	1837	Broken lime
1837	1894	Broken lime & shale
1894	1980	Lime
1980	2116	Broken lime
2116	2146	Shale & shells
2146	2190	Broken lime
2190	2245	Shale, sticky
2245	2716	Shale & shells
2716	2751	Porous sandy lime
2751	2885	Shale & shells
2885	2920	Broken lime
2920	2946	Shale & shells
2946	3440	Lime
3440	3445	Cored
3445	3448	Lime, cored
3448	3450	Siliceous lime
Set & cemented 7" O.D. casing with 200 sacks cement		
3450	3462	Lime

12-07-56

PLUGGING
SEC. 22 T. 11 S. 17 W.
PAGE 123 LINE 23