


STATE OF KANSAS
STATE CORPORATION COMMISSION

Form CP-4

WELL PLUGGING RECORD

Give All Information Completely
Make Required Affidavit
Mail or Deliver Report to:
Conservation Division
State Corporation Commission
P. O. Box 17027
Wichita, Kansas 67217

Ellis County. Sec. 22 Twp. 11 Rge. (E) 17 (W)
Location as "NE/CNW/SW" or footage from lines: NW SE SE
Lease Owner: Sohio Petroleum Company
Lease Name: Johansen Well No. 6
Office Address: Box 673, Russell, KS 67665
Character of Well (completed as Oil, Gas or Dry Hole): OWWO
Date well completed: June 7 19 77
Application for plugging filed: May 27 19 77
Application for plugging approved: May 31 19 77
Plugging commenced: June 6 19 77
Plugging completed: 10:45 A.M. June 7 19 77
Reason for abandonment of well or producing formation: OWWO - Unsuccessful
If a producing well is abandoned, date of last production: 19
Was permission obtained from the Conservation Division or its agents before plugging was commenced? Yes

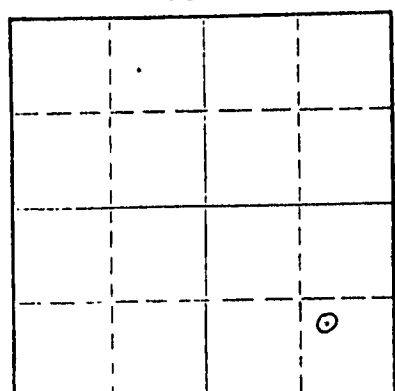

Locate well correctly on above Section Plat

Name of Conservation Agent who supervised plugging of this well: Leo Massey
Producing formation: Depth to top: Bottom: Total Depth of Well: 1697 Feet
Show depth and thickness of all water, oil and gas formations.

OIL, GAS OR WATER RECORDS

CASING RECORD

FORMATION	CONTENT	FROM	TO	SIZE	PUT IN	PULLED OUT
				10"	1121'	None
				7"	3383'	1521'
	This casing was left in hole when well was originally plugged. No new casing run.					

Describe in detail the manner in which the well was plugged, indicating where the mud fluid was placed and the method or methods used in introducing it into the hole. If cement or other plugs were used, state the character of same and depth placed, from feet to feet for each plug set.

OWWO. Attempted to re-enter old hole. Cleaned out and reached TD of 1697'. Unable to re-enter. Wellbore plugged and abandoned as follows. Pumped 40 sx 50-50 Pozmix cement, 10% salt down casing, followed with water to 450'. 20 sx 50-50 Poz w/salt from 30' up to base of cellar.

06-15-77

(If additional description is necessary, use BACK of this sheet)


Name of Plugging Contractor: Halliburton
Address:

STATE OF Kansas, COUNTY OF Russell, ss. W. H. Ward (employee of owner) of the above-described

well being first duly sworn on oath, says: That I have knowledge of the facts, statements, and matters herein contained and the log of the above-described well as filed and that the same are true and correct. So help me God.

(Signature) W. H. Ward
Box 673, Russell, KS 67665 (Address)

SWORN to before me this 13th day of June, 19 77

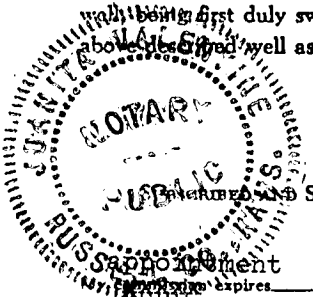

Juanita Valentine
Juanita Valentine Notary Public.

Commenced: 4-21-55
 Completed: 5-15-55

FEET	TO	DESCRIPTION
0	0	Cellar
0	35	Surface clay
Set & cemented 15" casing with 12 sacks cement		
35	505	Shale & shells
505	570	Sand <i>Leather</i>
570	585	Sandy shale
585	612	Pyrites of iron
612	642	Red bed
642	690	Shale & shells
690	768	Sand <i>chug</i>
768	840	Shale & shells
840	1040	Red bed
1040	1115	Shale & shells
1115	1115	Chalk
1115	1121	Anhydrite
Set & cemented 10" casing with 300 sacks cement at 1121'		
1121	1180	Anhydrite
1180	1240	Red bed
1240	1765	Shale & shells
1765	1785	Lime
1785	1845	Broken lime
1845	1920	Shale & shells
1920	2065	Broken lime
2065	2105	Shale, sticky
2105	2225	Broken lime
2225	2225	Red shale
2225	2300	Broken lime
2300	2325	Lime & shale
2325	2350	Broken lime
2350	2385	Shale
2385	2435	Shale & shells
2435	2545	Lime & shale
2545	2610	Shale & shells
2610	2707	Shale & lime
2707	2792	Shale & shells
2792	2922	Broken lime
2922	3005	Lime
3005	3040	Broken lime
3040	3122	Lime
3122	3180	Lime & shale
3180	3235	Lime
3235	3245	S. L. M. Correction
3245	3375	Lime
3375	3375	Green shale
3375	3385	Sand
3385	3385	Sand & shale
3385	3385	Lime
Set & cemented 7" O. D. casing with 150 sacks cement		
3385	3387	Lime, oil



MAY 31 1977
 05-31-77