


STATE OF KANSAS
STATE CORPORATION COMMISSION

Form CP-4

WELL PLUGGING RECORD

Give All Information Completely
Make Required Affidavit
Mail or Deliver Report to:
Conservation Division
State Corporation Commission
211 No. Broadway
Wichita, Kansas

T - 11S NORTH R - 17W

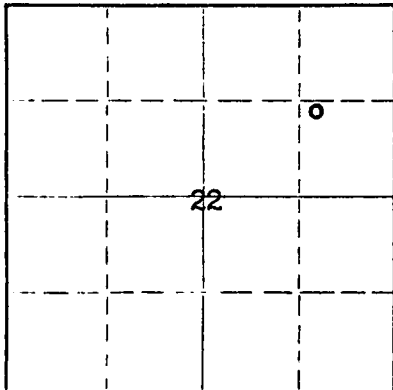

Locate well correctly on above
Section Plat

Ellis County, Sec. 22 Twp. 11 Rge. 17 (E) W (W)
Location as "NE/CNW/SW" or footage from lines NW SE NE
Lease Owner Frank J. Black
Lease Name J. Johensen Well No. 6
Office Address McPherson, Kansas
Character of Well (completed as Oil, Gas or Dry Hole) Oil
Date well completed 12-1-37 19
Application for plugging filed 3-2-66 19
Application for plugging approved 3-3-66 19
Plugging commenced 3-14-66 19
Plugging completed 3-26-66 19
Reason for abandonment of well or producing formation Depleted.

If a producing well is abandoned, date of last production 19
Was permission obtained from the Conservation Division or its agents before plugging was commenced? yes

Name of Conservation Agent who supervised plugging of this well Massey
Producing formation _____ Depth to top _____ Bottom _____ Total Depth of Well 3407 Feet
Show depth and thickness of all water, oil and gas formations.

OIL, GAS OR WATER RECORDS

CASING RECORD

FORMATION	CONTENT	FROM	TO	SIZE	PUT IN	PULLED OUT
				16"	50'	None
				7"	3401'	2400'
				10-3/4"	1165'	None

Describe in detail the manner in which the well was plugged, indicating where the mud fluid was placed and the method or methods used in introducing it into the hole. If cement or other plugs were used, state the character of same and depth placed, from _____ feet to _____ feet for each plug set.

Checked hole to 3407', sanded to 3375' and dumped 5 sacks of cement @ 3375' with dump bailer. Pulled 7" casing, mudded hole to 480', set rock bridge to 470' and pumped in 40 sacks of cement @ 470'. Pumped 10 sacks of gel mud to 40', set rock bridge to 30' and ran 15 sacks of cement to base of cellar.

RAW
04-12-66

PLUGGING COMPLETE.

(If additional description is necessary, use BACK of this sheet)
Name of Plugging Contractor KNIGHT CASING PULLING COMPANY License #436
Address CHASE, KANSAS

STATE OF KANSAS, COUNTY OF RICE, ss.
Noel J. Knight (employee of owner) or ~~owner or operator~~ of the above-described well, being first duly sworn on oath, says: That I have knowledge of the facts, statements, and matters herein contained and the log of the above-described well as filed and that the same are true and correct. So help me God.

(Signature) *Noel J. Knight*
Chase, Kansas
(Address)

SUBSCRIBED AND SWORN TO before me this 29th day of March, 1966

My commission expires May 20, 1968 *William J. ...* Notary Public.

15-051-65818-00-00

WELL LOG BUREAU - KANSAS GEOLOGICAL SOCIETY.
412 Union National Bank Bldg, Wichita, Kansas.

MAGNOLIA PETROLEUM CO.
J. Johansen No. 6


SEC. 22 T. 11 R. 17W.
NW SE NE

Total Depth. 3407.
Comm. 11-4-37 Comp. 12-1-37
Shot or Treated.
Contractor.
Issued. 1-15-88

County Ellis.

CASING.

16" 50'
103/4" 1165'
7" 3401

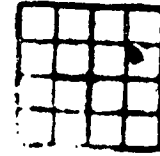

Elevation.

Production. Pot. 1709 B.

Figures Indicate Bottom of Formations.

red bed and shell	50
gravel lime and shell	400
red bed	460
sand	528
lime and shale	650
sand	710
lime and shale	992
shale and shells	1135
anhydrite	1170
red bed	1270
rod rock sholls	1505
shale and shells	1732
shale and lime	1980
lime	2255
lime and shale	2660
shale and shells	2680
lime and shale	2700
lime	2737
broken lime	2784
lime and shale	2844
lime	3030
broken lime	3146
lime show oil	3156
broken lime	3199
lime	3380
Top Simpson	3380
shale and sand	3401
Top Arbuckle	3401
cored 3' recovery.	3400 to 3404
Standardized.	
Arbuckle lime	3407

Total Depth.

RECEIVED
STATE CORPORATION COMMISSION

APR 12 1966
04-12-66
REGISTRATION DIVISION
Wichita, Kansas