


WELL PLUGGING RECORD

Give All Information Completely
Make Required Affidavit
Mail or Deliver Report to:
Conservation Division
State Corporation Commission
211 No. Broadway
Wichita, Kansas

Ellis County, Sec. 22 Twp. 11 Rge. (EX) 17 (W)

Location as "NE/CNW/SW" or footage from lines S 7 S 7 SE
Lease Owner Sohio Petroleum Company
Lease Name Johansen Well No. 1
Office Address Box 673, Russell, Kansas
Character of Well (completed as Oil, Gas or Dry Hole) oil
Date well completed 6-26 1937
Application for plugging filed 12-22 1958
Application for plugging approved 12-24 1958
Plugging commenced 1-22 1959
Plugging completed 1-25 1959
Reason for abandonment of well or producing formation Uneconomical

NORTH

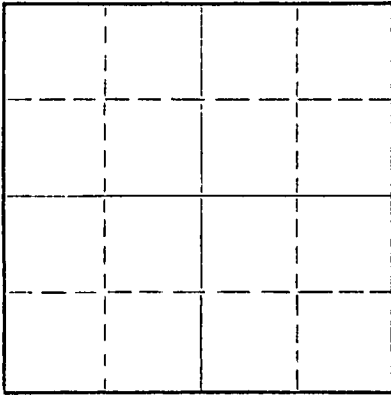

Locate well correctly on above
Section Plat

If a producing well is abandoned, date of last production December 1958
Was permission obtained from the Conservation Division or its agents before plugging was commenced? yes

Name of Conservation Agent who supervised plugging of this well Aldon Petty
Producing formation Arbuckle Depth to top _____ Bottom _____ Total Depth of Well 3525 Feet
Show depth and thickness of all water, oil and gas formations. POTD 3200'

OIL, GAS OR WATER RECORDS

CASING RECORD

FORMATION	CONTENT	FROM	TO	SIZE	PUT IN	PULLED OUT
Arbuckle			Liner	5 1/2" 7"	3523' 3434'	none 2337'

Describe in detail the manner in which the well was plugged, indicating where the mud fluid was placed and the method or methods used in introducing it into the hole. If cement or other plugs were used, state the character of same and depth placed, from _____ feet to _____ feet for each plug set.

Bridged hole at 3075'. Placed 15' sand on top and dumped 5 sacks cement.

3000' to 450' - heavy mud and 50 sacks cement
450' to 180' - 30 sacks cement
180' to 25' - 5' rock bridge
25' to cellar - 10 sacks cement.

RECEIVED
STATE CORPORATION COMMISSION

FEB 2 1959

CONSERVATION DIVISION
Wichita, Kansas

(If additional description is necessary, use BACK of this sheet)

Name of Plugging Contractor West Supply Company
Address Chase, Kansas

STATE OF Kansas, COUNTY OF Russell, ss.
J. H. Bond (employee of owner) or (owner or operator)

of the above-described well, being first duly sworn on oath, says: That I have knowledge of the facts, statements, and matters herein contained and the log of the above-described well as filed and that the same are true and correct. So help me God.

(Signature) J. H. Bond
(Address) _____

SUBSCRIBED AND SWORN TO before me this 26th day of January, 19 59

My commission expires July 2, 1961

Notary Public.

