


WELL PLUGGING RECORD

Give All Information Completely
 Make Required Affidavit
 Mail or Deliver Report to:
 Conservation Division
 State Corporation Commission
 211 No. Broadway
 Wichita, Kansas

Ellis County. Sec. 22 Twp. 11 Rge. (E) 17 (W)
 Location as "NE/CNW/SW" or footage from lines SE NE SW
 Lease Owner Sohio Petroleum Company
 Lease Name Bemis "C" Well No. 7
 Office Address Box 673, Russell, Kansas
 Character of Well (completed as Oil, Gas or Dry Hole) oil
 Date well completed 6-27 19 37
 Application for plugging filed 2-7 19 59
 Application for plugging approved 2-9 19 59
 Plugging commenced 2-26 19 59
 Plugging completed 3-3 19 59
 Reason for abandonment of well or producing formation Uneconomical

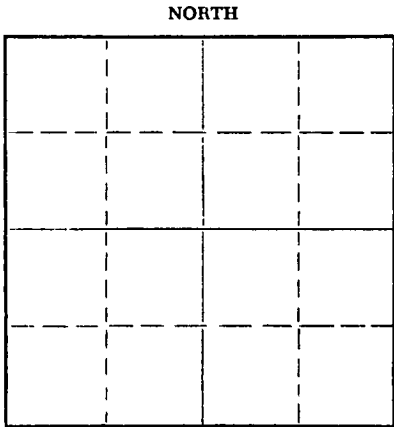

Locate well correctly on above Section Plat

If a producing well is abandoned, date of last production June 19 58
 Was permission obtained from the Conservation Division or its agents before plugging was commenced? yes

Name of Conservation Agent who supervised plugging of this well Eldon Petty
 Producing formation Arbuckle Depth to top _____ Bottom _____ Total Depth of Well 3481 Feet
 Show depth and thickness of all water, oil and gas formations.

OIL, GAS OR WATER RECORDS

CASING RECORD

FORMATION	CONTENT	FROM	TO	SIZE	PUT IN	PULLED OUT
Arbuckle				7"	3473'	2612'

Describe in detail the manner in which the well was plugged, indicating where the mud fluid was placed and the method or methods used in introducing it into the hole. If cement or other plugs were used, state the character of same and depth placed, from _____ feet to _____ feet for each plug set.

Dumped sand to 3460' placed 5 sacks cement on top of sand.
Pulled casing to 735', circulated pipe using 30 sacks mud followed by 30 sacks of cement. Pulled casing to 360' and spotted 30 sacks cement. Placed 5' rock bridge and dumped 10 sacks of cement up to bottom of cellar.

MAR 5 1959
 CONSERVATION DIVISION
 Wichita, Kansas

(If additional description is necessary, use BACK of this sheet)
 Name of Plugging Contractor West Supply Company
 Address Chase, Kansas

STATE OF Kansas, COUNTY OF Russell, ss.
J. H. Bond (employee of owner) ~~or (owner or operator)~~ of the above-described well, being first duly sworn on oath, says: That I have knowledge of the facts, statements, and matters herein contained and the log of the above-described well as filed and that the same are true and correct. So help me God.

(Signature) J. H. Bond
 (Address) _____

SUBSCRIBED AND SWORN TO before me this 14th day of March, 1959

My commission expires March 25, 1961 Notary Public.

PLUGGING
 FEB 22 11 17W
 BOOK PAGE 14 LINE 38

15-051-05835-0001

LOG OF WELL NO. 1022
 Section 22 T. 11 R. 17W

FROM	TO	DESCRIPTION	FROM	TO	DESCRIPTION
0	10	Cellar	2038	2200	Brine
10	32	Surface clay	2200	2250	Clay
Set & cemented 18 1/2" casing			2250	2332	Brine
32	310	Clay & shale	2332	2352	Clay
310	602	Shale & shells	2352	2370	Shale
602	678	Sand	2370	2385	Clay
678	688	Iron pyrites	2385	2392	Shale
688	775	Shale & shells	2392	2565	Clay
775	858	Sand	2565	2575	Clay & shale
858	930	Shale & shells	2575	2700	Shale
930	945	Sand	2700	2714	Clay, shale & shells
945	1040	Shale	2714	2730	Clay & shale
1040	1060	Sand	2730	2750	Clay & shale
1060	1146	Shale & shells	2750	2771	Shale, shale
1146	1194	Red rock & shale	2771	2785	Clay
1194	1198	Chalk	2785	2798	Shale & shells
1198	1198	Chalk	2798	3185	Clay
1198	1208	Anhydrite	3185	3210	Clay, shale
1208	1218	S. I. M. Correction	3210	3340	Clay
Set & cemented 12" casing with 300 sacks cement			3340	3354	Clay, shale & shells
1218	1240	Anhydrite	3354	3414	Clay
1240	1249	Lime	Set & cemented 7 1/2" casing with 150 sacks cement		
1249	1289	Red rock			
1289	1314	Red rock			
1314	1395	Lime & shale			
1395	1440	Lime			
1440	1575	Red rock & shale			
1575	1590	Shale & shells			
1590	1751	Salt			
1751	1842	Shale & shells			
1842	1910	Lime, broken			
1910	1959	Lime			
1959	2036	Lime			

RECEIVED
 STATE CORPORATION COMMISSION

FEB 6 1959

CONSERVATION DIVISION
 WICHITA, KANSAS

PLUGGING
 FILE SEC 22 T. 11 R. 17W
 BOOK PAGE 14 LINE 32