


WELL PLUGGING RECORD

Give All Information Completely
Make Required Affidavit
Mail or Deliver Report to:
Conservation Division
State Corporation Commission
800 Bitting Building
Wichita, Kansas

NORTH

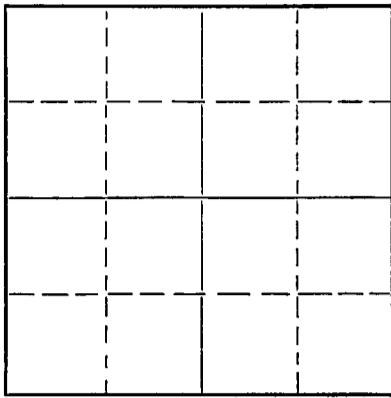

Locate well correctly on above
Section Plat

Location as "NE/CNW $\frac{1}{4}$ SW $\frac{1}{4}$ " or footage from lines Center of SW 1/4 No
County, Sec. 22 Twp. 11 Rge. (E) 17 (W)
Lease Owner Cities Service Oil Co.
Lease Name Johnson "A" Well No. 3
Office Address Wartlesville, Oklahoma
Character of Well (completed as Oil, Gas or Dry Hole) oil
Date well completed 9-11-37 19
Application for plugging filed 9-23-52 19
Application for plugging approved 9-24-52 19
Plugging commenced 10-4-52 19
Plugging completed 10-8-52 19
Reason for abandonment of well or producing formation Won commercial

If a producing well is abandoned, date of last production 9-30-52 19
Was permission obtained from the Conservation Division or its agents before plugging was commenced? Yes

Name of Conservation Agent who supervised plugging of this well Mr. Eldon Betty
Producing formation Arbuckle Depth to top 3453' Bottom None Total Depth of Well 3460' Feet
Show depth and thickness of all water, oil and gas formations.

OIL, GAS OR WATER RECORDS

CASING RECORD

Formation	Content	From	To	Size	Put In	Pulled Out
				15"	102'	0
				7"	3453'	597'

Describe in detail the manner in which the well was plugged, indicating where the mud fluid was placed and the method or methods used in introducing it into the hole. If cement or other plugs were used, state the character of same and depth placed, from _____ feet to _____ feet for each plug set.

Filled with rock to 3440', 5 sx. cement to 3410', filled with mud to 300', set rock bridge. Dumped 25 sx. cement, mud to 35', 10 sx. cement to surface.

(If additional description is necessary, use BACK of this sheet)

Name of Plugging Contractor Miller Casing Pulling Co. 10-21-52
Address Great Bend, Kansas

STATE OF KANSAS, COUNTY OF BARTON
James Porter (employee of owner) or (owner or operator) of the above-described well,

being first duly sworn on oath, says: That I have knowledge of the facts, statements, and matters herein contained and the log of the above-described well as filed and that the same are true and correct. So help me God.

(Signature) James Porter

Box 553, Russell, Kansas
(Address)

SUBSCRIBED AND SWORN to before me this 15th day of October, 1952

W. G. Smith
Notary Public.

My commission expires 3-12-1955

PLUGGING
FILE SEC 22 T 11 R 1724
BOOK PAGE 46 LINE 45

WELL RECORD

15-051-05812-0000

Company..... Cities Service Oil Co. Well No. 3 Farm Johansen "A"
 Location..... 330' N. & 330' E. of W/16 Cor. of NE/4 Sec. 22 T. 11 R. 17W
 Elevation..... County Ellis State Kansas
 Drlg. Comm. August 11, 1937 Contractor J. E. Mabee Drilling Co.
 Drlg. Comp. Sept. 11, 1937 Acid None
 T. D. 3460' Initial Prod. 2203 oil, 0 water, 24 hrs. natural

CASING RECORD:

16" OD 93' cem. 90 sx
 10-3/4" OD 1150' cem. 492 sx
 7" OD 3453' cem. 256 sx

FORMATION RECORD:

shale & shells	202
shale	238
shale, shells & sand	295
shale & sand	320
shale & shells	510
sand & pyrite of iron	610
shale & shells	644
sand hard	648
shale	675
shale, shells	684
sand	790
shale & red bed	874
shale & shells	895
shale sticky	930
shale & shells	1150
anhydrite lime	1187
shale & shells	1325
sticky shale	1398
shale & shells	1535
salt	1680
shale & shells	1737
lime broken	1887
lime & shale	2081
lime	2156
lime hard	2174
lime & shale	2176
lime	2203
shale & lime	2535
shale & shells	2725
lime & shale	2885
broken lime	2899
lime	3146
lime soft	3155
lime	3267
SIM Corr. 3267 = 3270	
lime	3424
lime & shale	3445
shale cored	3447

sand cored	3449
shale cored	3454
lime cored	3455
SIM Corr. 3455 = 3454	
lime	3460 T. D.

Top Siliceous lime	3453'
Penetration	7'
Total Depth	3460'

Total fillup 2950' oil in 10 hrs.

SYFO RECORD:

500'	OK
1000'	0°
1500'	0°
2000'	0°
2500'	1/2°
3000'	1-1/2°

PLUGGING
 FILE SEC 22 T 11 R 17W
 BOOK PAGE 46 LINE 45

09-24-52