

Give All Information Completely  
Make Required Affidavit  
Mail or Deliver Report to:  
Conservation Division  
State Corporation Commission  
211 No. Broadway  
Wichita, Kansas

WELL PLUGGING RECORD

ELLIS County. Sec. 22 Twp. 11S Rge. 17W (E) (W)

Location as "NE/CNW\*SW\*" or footage from lines SW/SE/NE

Lease Owner FRANK J. BLACK

Lease Name J. JOHANSEN Well No. 14

Office Address Box 150, McPherson, Kansas

Character of Well (completed as Oil, Gas or Dry Hole) Oil

Date well completed 6-23-38 19

Application for plugging filed 10-4-65 19

Application for plugging approved 10-5-65 19

Plugging commenced October 29, 1965 19


Plugging completed November 1, 1965 19

Reason for abandonment of well or producing formation Depleted

If a producing well is abandoned, date of last production 19

Was permission obtained from the Conservation Division or its agents before plugging was commenced? Yes

T - 11S NORTH R - 17W

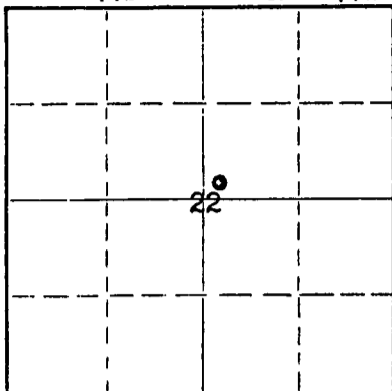

Locate well correctly on above Section Plat

Name of Conservation Agent who supervised plugging of this well Gilbert Leiker, Victoria, Kansas

Producing formation Depth to top Bottom Total Depth of Well 3389' Feet

Show depth and thickness of all water, oil and gas formations.

OIL, GAS OR WATER RECORDS

CASING RECORD

FORMATION	CONTENT	FROM	TO	SIZE	PUT IN	PULLED OUT
				16"	59'	None
				10-3/4"	1125'	None
				7"	3383'	2595'

Describe in detail the manner in which the well was plugged, indicating where the mud fluid was placed and the method or methods used in introducing it into the hole. If cement or other plugs were used, state the character of same and depth placed, from feet to feet for each plug set.

Plugged back with sand to 3380- feet, dumped 5- sacks cement.  
Circulated Mud at 500- feet, pumped 30- sacks cement at 450- feet.  
Pumped 30- sacks cement at 200- feet, put ten sacks cement on top.

PLUGGING COMPLETE.

NOV 12 1965  
11-12-65

(If additional description is necessary, use BACK of this sheet)

Name of Plugging Contractor LYNCH CASING PULLING COMPANY. NO. 457

Address R.Rt. 4 GREAT BEND, KANSAS

STATE OF KANSAS, COUNTY OF MCPHERSON, ss.

Frank J. Black (owner) of the above-described well, being first duly sworn on oath, says: That I have knowledge of the facts, statements, and matters herein contained and the log of the above-described well as filed and that the same are true and correct. So help me God.

(Signature)

Box 150, McPherson, Kansas (Address)

SUBSCRIBED AND SWORN TO before me this 9th day of November, 1965

My commission expires July 16, 1967

JERRY PELTZMAN Notary Public.


WELL LOG BUREAU - KANSAS GEOLOGICAL SOCIETY  
 112 N. 1st St., Wichita, Kansas

MAGNOLIA PETRO. CO.  
 J. Johansen No. 14.

SEC. 22 T. 11 R. 17  
 SW SE NE

County. Ellis

Total Depth. 3389'  
 Comm. 5-31-38 Comp. 6-23-38  
 Shot or Treated.  
 Contractor.  
 Issued. 7-30-38

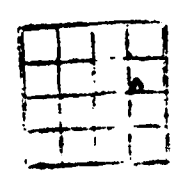

Elevation.

Production. Pot. 2634 B. Nat

CASING:  
 16 " 59'  
 10 3/4 " 1125'  
 7 " 3383'

Figures Indicate Bottom of Formations.

surface	59	lime	3065
shale blk & shells	203	lime hrd	3098
shale & shells	465	lime	3360
sand	523	Top Simpson sh oil	3360
lime	550	dolomite & green shale	
sand	560	Simpson	3382
lime & shale	690	Top Arbuckle	3382
sand	760	cored	3384
shale & shells	887	5 1/2' recovery	
red bed & shale	977	Arbuckle lime	3384
shale & shells	1104	SLM Correction	3384=3385
Top Anhydrite	1104	Top Simpson	3361 Corrected.
anhydrite	1144	Top Arbuckle	3383 Corrected.
red rock	1460	Arbuckle lime	3385-89 Corr.
salt	1673		
shale & shells	1735	Total Depth	SLM 3389
shale	1800		
lime	1822		
shale	1838		
lime & shale	1860		
lime	1950		
shale & lime	2016		
lime	2055		
shale & shells	2075		
lime	2120		
shale & shells	2150		
lime	2170		
shale & shells	2250		
rod rock	2270		
sand	2290		
lime	2423		
shale & lime	2510		
shale & shells	2655		
brkn lime	2753		
brkn lime & shale	2810		
lime	2994		
lime hrd	3015		
brkn lime	3029		

RECEIVED  
 STATE CORPORATION COMMISSION

NOV 12 1965

CONSERVATION DIVISION  
 Wichita, Kansas