


WELL PLUGGING RECORD

Give All Information Completely
Make Required Affidavit
Mail or Deliver Report to:
Conservation Division
State Corporation Commission
211 No. Broadway
Wichita, Kansas

T - 11S NORTH R - 17W

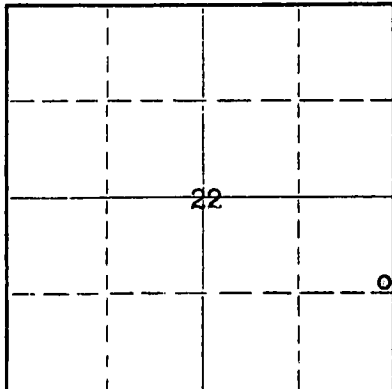

Locate well correctly on above
Section Plat

ELLIS County. Sec. 22 Twp 11S Rge. 17W (E) (W)
Location as "NE/CNW/SW" or footage from lines SE/NE/SE
Lease Owner FRANK J. BLACK
Lease Name J. JOHANSEN Well No. 10
Office Address Box 150, McPherson, Kansas
Character of Well (completed as Oil, Gas or Dry Hole) Oil
Date well completed 3-2-38 19
Application for plugging filed 10-4-65 19
Application for plugging approved 10-5-65 19
Plugging commenced November 13, 1965 19
Plugging completed November 18, 1965 19
Reason for abandonment of well or producing formation Depleted

If a producing well is abandoned, date of last production 19
Was permission obtained from the Conservation Division or its agents before plugging was commenced? Yes

Name of Conservation Agent who supervised plugging of this well GILBERT LEIKER, VICTORIA, KANSAS
Producing formation _____ Depth to top _____ Bottom _____ Total Depth of Well 3373' Feet
Show depth and thickness of all water, oil and gas formations.

OIL, GAS OR WATER RECORDS

CASING RECORD

FORMATION	CONTENT	FROM	TO	SIZE	PUT IN	PULLED OUT
				16"	63'	None
				10-3/4"	1128'	None
				7"	3368'	1520'

Describe in detail the manner in which the well was plugged, indicating where the mud fluid was placed and the method or methods used in introducing it into the hole. If cement or other plugs were used, state the character of same and depth placed, from _____ feet to _____ feet for each plug set.

Plugged, back with sand to 3360 feet, dumped 5 sacks cement.
Circulated Mud at 500 feet, pumped 30 sacks cement at 450 feet.
Pumped 20 sacks cement at 200 feet, put ten sacks on top.

PLUGGING COMPLETE

NOV 24 1965 11-24-65
STATE CORPORATION COMMISSION
WICHITA, KANSAS

(If additional description is necessary, use BACK of this sheet)

Name of Plugging Contractor LYNCH CASING PULLING, COMPANY. NO. 457
Address R.Rt. 4 GREAT BEND, KANSAS

STATE OF KANSAS, COUNTY OF MCPHERSON, ss.
Frank J. Black

(employee of owner or operator) of the above-described well, being first duly sworn on oath, says: That I have knowledge of the facts, statements, and matters herein contained and the log of the above-described well as filed and that the same are true and correct. So help me God.

(Signature) Frank J. Black
Box 150, McPherson, Kansas
(Address)

SUBSCRIBED AND SWORN TO before me this 23rd day of November 1965

My commission expires July 16, 1967

Jerry Peltzman
JERRY PELTZMAN Notary Public.

WELL LOG BUREAU - KANSAS GEOLOGICAL SOCIETY.
412 Union National Bk Bldg., Wichita, Kansas.

g h J. Black

15-051-05822-0000

MAGNOLIA PETRO. CO.
J. Johansen No. 10.

SEC. 22 T. 11 R. 17W
SE NE SE

Total Depth. 3373' SLM
Comm. 2-5-38 Comp. 3-2-38
Shot or Treated.
Contractor.
Landed. 4-16-38

County. Ellis

CASING:
16 " 63'
10³/₄" 1128'
7 " 3368'



Elevation.

Production. Pot. 2203 B.

Figures Indicate Bottom of Formations.

cellar	7
sand & shells	63
shale & shells	490
sand	577
pyrite	600
shale & shells	679
sand sft	765
sand & pyrite	795
red bed	820
red bed & shells	1107
anhydrite	1145
red rock	1181
shale & shells	1394
brkn lime	1425
shale & shells	1730
brkn lime & shale	1845
shale & shells	1980
brkn lime	2092
limo	2170
brkn lime	2342
limo	2360
shale & limo shells	2635
brkn limo	2809
lime	3093
brkn limo	3196
limo	3365
Top Simpson 3358	
limo	3368
Cored 5' Roc 3368-71	
Top Arbucklo 3368	
good sh oil 3368-71	
Standardized	
Arbucklo limo	SLM 3373
Total Dophth.	

RECEIVED
STATE CORPORATION COMMISSION

NOV 24 1965

CONSERVATION DIVISION
Wichita, Kansas