


15-051-05821-0000

STATE OF KANSAS  
STATE CORPORATION COMMISSION

Form CP-4

Give All Information Completely  
Make Required Affidavit  
Mail or Deliver Report to:  
Conservation Division  
State Corporation Commission  
211 No. Broadway  
Wichita, Kansas

WELL PLUGGING RECORD

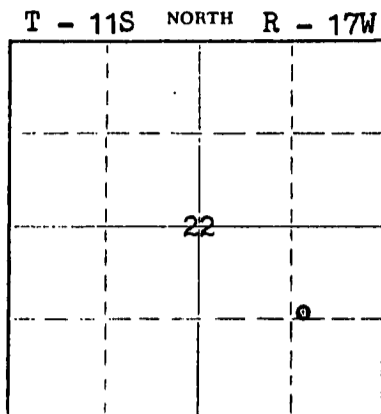

Locate well correctly on above  
Section Plat

ELLIS County. Sec. 22 Twp. 11S Rge. 17W (E) (W)  
 Location as "NE/CNW&SW" or footage from lines SW/NE/SE  
 Lease Owner Frank J. Black, ~~Oil Field Equipment~~  
 Lease Name J. Johansen AUGVCC Well No. 9  
 Office Address Box 150, McPherson, Kansas  
 Character of Well (completed as Oil, Gas or Dry Hole) Oil  
 Date well completed 2-1-38 19  
 Application for plugging filed 10-4-65 19  
 Application for plugging approved 10-5-65 19  
 Plugging commenced October 10, 1965 19  
 Plugging completed October 13, 1965 19  
 Reason for abandonment of well or producing formation Depleted

If a producing well is abandoned, date of last production 19  
 Was permission obtained from the Conservation Division or its agents before plugging was commenced? Yes

Name of Conservation Agent who supervised plugging of this well Eldon Petty, Hays, Kansas  
 Producing formation \_\_\_\_\_ Depth to top \_\_\_\_\_ Bottom \_\_\_\_\_ Total Depth of Well 3418 Feet  
 Show depth and thickness of all water, oil and gas formations.

OIL, GAS OR WATER RECORDS

CASING RECORD

FORMATION	CONTENT	FROM	TO	SIZE	PUT IN	PULLED OUT
				16"	56'	None
				10-3/4"	1158'	None
				7"	3413'	2532'

Describe in detail the manner in which the well was plugged, indicating where the mud fluid was placed and the method or methods used in introducing it into the hole. If cement or other plugs were used, state the character of same and depth placed, from \_\_\_\_\_ feet to \_\_\_\_\_ feet for each plug set.

Plugged back with sand to 3400- feet, dumped 5- sacks cement.  
 Circulated Mud at 550- feet, pumped 30- sacks cement at 450- feet.  
 Pumped 30- sacks cement at 200- feet, put ten sacks cement on top.

RECEIVED  
STATE CORPORATION COMMISSION

PLUGGING COMPLETE.

OCT 21 1965  
10-21-65

CONSERVATION DIVISION  
Wichita, Kansas

(If additional description is necessary, use BACK of this sheet)  
 Name of Plugging Contractor LYNCH CASING PULLING, COMPANY. NO. 457  
 Address R.Rt. 4 GREAT BEND, KANSAS

STATE OF KANSAS, COUNTY OF MCPHERSON, ss.  
 Frank J. Black (owner) of the above-described

well, being first duly sworn on oath, says: That I have knowledge of the facts, statements, and matters herein contained and the log of the above-described well as filed and that the same are true and correct. So help me God.

(Signature)   
 Box 150, McPherson, Kansas (Address)

SUBSCRIBED AND SWORN TO before me this 20th day of October, 1965

My commission expires July 16, 1967  
 Jerry Peltzman Notary Public.

WELL LOG BUREAU - KANSAS GEOLOGICAL SOCIETY.  
412 Union National Bk Bldg., Wichita, Kansas.


15-051-05821-0000

MAGNOLIA PETRO. CO.  
J. Johansen No. 9.

SEC. 22 T. 11 N. R. 17W  
SW NE SE

Total Depth. 3418'  
Comm. 1-7-38 Comp. 2-1-38  
Shot or Treated.  
Contractor.  
Issued. 3-5-38

County. Ellis

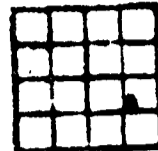

CASING:  
16 " 56'  
10<sup>3</sup>/<sub>4</sub>" 1158'  
7 " 3413' Corr.

Elevation.

Production. Pot. 2662 B.

Figures Indicate Bottom of Formations.

cellar	7
red bed & shells	315
sand & gravel	375
shale & shells	620
pyrite	628
shale & shells	720
sand	805
red bed & shells	1138
anhydrite	1180
shale & shells	1440
brkn lime	1480
shale & shells	2020
lime & shale	2352
shale & shells	2810
lime & shale	2863
brkn lime	2895
show oil	2875
lime	3090
brkn lime	3148
lime	3400
brkn. lime	3404
Top Simpson	3400
cored 8' recovery	3403-3412
Top Arbuckle	3410
Arbuckle lime	3412
Standardized	
SIM Correction	3412=3415
Top Simpson	3403 Corr.
Top Arbuckle	3413 Corr.
cored	3406-3415 Corr.
Arbuckle lime	SIM 3418
Total Depth.	

RECEIVED  
STATE CORPORATION COMMISSION

OCT 21 1938

CONSERVATION DIVISION  
Wichita, Kansas