


WELL PLUGGING RECORD

Give All Information Completely
Make Required Affidavit
Mail or Deliver Report to:
Conservation Division
State Corporation Commission
800 Bitting Building
Wichita, Kansas

Ellis County, Sec. 19 Twp. 13 Rge. 18 (E) (W)

Location as "NE/CNW $\frac{1}{4}$ /SW $\frac{1}{4}$ " or footage from lines SW Cr SW/4
Lease Owner Virginia Drlg Co Inc et al
Lease Name Brull Well No. 1
Office Address 701 Brown Bldg. Wichita 2, Kansas
Character of Well (completed as Oil, Gas or Dry Hole) Dryhole
Date well completed 6-8-52 19
Application for plugging filed 6-8-52 19
Application for plugging approved 6-8-52 19
Plugging commenced 6-8-52 19
Plugging completed 6-8-52 19
Reason for abandonment of well or producing formation

NORTH

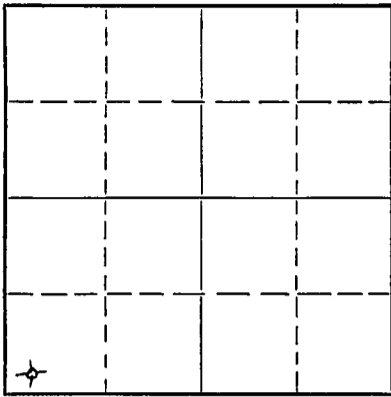

Locate well correctly on above
Section Plat

If a producing well is abandoned, date of last production 19
Was permission obtained from the Conservation Division or its agents before plugging was commenced? yes

Name of Conservation Agent who supervised plugging of this well Eldon Petty
Producing formation Depth to top Bottom Total Depth of Well 3718 Feet
Show depth and thickness of all water, oil and gas formations.

OIL, GAS OR WATER RECORDS

CASING RECORD

Formation	Content	From	To	Size	Put In	Pulled Out
		0	207	8 5/8	211.79	none

Describe in detail the manner in which the well was plugged, indicating where the mud fluid was placed and the method or methods used in introducing it into the hole. If cement or other plugs were used, state the character of same and depth placed, from feet to feet for each plug set.

Mudded hole to 190 ft. - plugged with 150 sx cement
Mudded hole to 40 ft. - plugged to top with 10' sx cement

RECEIVED
JUN 12 1952
CONSERVATION DIVISION
Wichita, Kansas

(If additional description is necessary, use BACK of this sheet)
Name of Plugging Contractor Virginia Drlg Co Inc
Address 701 Brown Bldg. Wichita 2, Kansas

STATE OF Kansas, COUNTY OF Sedgwick, ss.
S. A. Murphy (employee of owner) or (owner or operator) of the above-described well,
being first duly sworn on oath, says: That I have knowledge of the facts, statements, and matters herein contained and the log of the above-described well as filed and that the same are true and correct. So help me God.

(Signature) *S. A. Murphy*
701 Brown Bldg., Wichita 2, Kansas (Address)

SUBSCRIBED AND SWORN to before me this 11th day of June, 1952
Murlee Hawkins Notary Public

My commission expires February 5, 1953 23-8390-s 6-51-20M

PLUGGING
FILE SEC 19T 13 R 16W
BOOK PAGE 22 LINE 26

15-051-00080-00-00


Well: Brull #1
 Location: SW Corner SW/4 Section 19-13-18, Ellis County, Kansas
 Company: Virginia Drilling Co., Inc. et al
 Contractor: Virginia Drilling Co., Inc.
 Commenced: May 28, 1952
 Completed: June 9, 1952
 Total Depth: 3718
 Elevation: 2020 D.F.

FORMATION	DEPTH	
Sand	0-85	
Shale-shells	85-175	
Shale-shells	175-207	
Shale-sand	207-625	
Shale-shells	625-790	Set 8-5/8" csg. @ 207'
Sand-clay	790-1000	
Shale-shells	1000-1320	
Lime-shale	1320-1380	TOPS:
Shale-shells	1380-1640	
Shale-lime	1640-1910	Heebner 3301
Shale-shells	1910-2090	Toronto 3320
Lime-shale	2090-2780	Lansing-K.C. 3347
Brk. lime	2780-2895	Base K. C. 3592
Lime-shale	2895-3169	Conglomerate 3630
Lime	3169-3570	Arbuckle 3671
Lime-shale	3570-3623	
Lime	3623-3635	
Cherty Lime	3635-3718	

Now comes S. A. Murphy, who states that he is familiar with the drilling of oil and gas wells, and knows of his own knowledge that the Brull #1, located in the SW Corner of the SW/4 Section 19-13-18, Ellis County, Kansas, was drilled to a total depth of 3718 feet.


 S. A. Murphy

Subscribed and sworn to before me, A Notary Public, this 9th day of June, 1952.

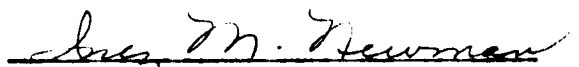
 Notary Public

My commission expires March 15, 1954.

RECEIVED
 STATE COMMISSIONER OF
 CONSERVATION DIVISION
 Wichita, Kansas

REC-110-21140
 SEC 19 T 13 R 18 W
 BOOK PAGE 221 LINE 42