


STATE OF KANSAS
STATE CORPORATION COMMISSION

Give All Information Completely
Make Required Affidavit
Mail or Deliver Report to:
Conservation Division
State Corporation Commission
11 No. Broadway
Wichita, Kansas

15-051-01475-00-00
WELL PLUGGING RECORD

Ellis County. Sec. 20 Twp. 13S Rge. (E) 18 (W)

NORTH

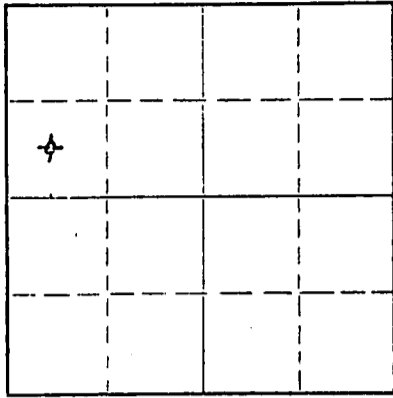

Locate well correctly on above Section Plat

Location as "NE/CNW/SW" or footage from lines 60' W of SW NW
Lease Owner Graybol Oil Corporation
Lease Name Brull Well No. 1
Office Address 2200 N. B. T. Bldg., Tulsa, Oklahoma
Character of Well (completed as Oil, Gas or Dry Hole) Dry Hole
Date well completed September 3 19 62
Application for plugging filed September 5 19 62
Application for plugging approved September 6 19 62
Plugging commenced September 4 19 62
Plugging completed September 4 19 62
Reason for abandonment of well or producing formation Dry Hole

If a producing well is abandoned, date of last production 19
Was permission obtained from the Conservation Division or its agents before plugging was commenced? Yes

Name of Conservation Agent who supervised plugging of this well Eldon Petty
Producing formation None Depth to top Bottom Total Depth of Well 3774' Feet
Show depth and thickness of all water, oil and gas formations.

OIL, GAS OR WATER RECORDS

CASING RECORD

FORMATION	CONTENT	FROM	TO	SIZE	PUT IN	PULLED OUT
Topeka	Saltwater	3120	3365	8 5/8"	177'	None
Lansing-Kansas City	Saltwater	3412	3643			
Arbuckle	Saltwater	3736	3774			

Describe in detail the manner in which the well was plugged, indicating where the mud fluid was placed and the method or methods used in introducing it into the hole. If cement or other plugs were used, state the character of same and depth placed, from feet to feet for each plug set.

Filled hole with heavy mud-laden fluid. Squeezed 20 sacks of cement through drill pipe @ 550'. Squeezed 20 sacks of cement through drill pipe @ 170'. Squeezed 10 sacks of cement at top of surface casing.

RECEIVED
STATE CORPORATION COMMISSION

SEP 10 1962

CONSERVATION DIVISION
Wichita, Kansas

(If additional description is necessary, use BACK of this sheet)

Name of Plugging Contractor Graybol Oil Corporation
Address 2200 National Bank of Tulsa Building, Tulsa 3, Oklahoma

STATE OF OKLAHOMA, COUNTY OF Tulsa, ss.
Lyman C. Dennis (employee of owner) or (owner or operator) of the above-described well, being first duly sworn on oath, says: That I have knowledge of the facts, statements, and matters herein contained and the log of the above-described well as filed and that the same are true and correct. So help me God.

(Signature) Lyman C. Dennis

Tulsa, Oklahoma
(Address)

SUBSCRIBED AND SWORN TO before me this 7th day of September, 19 62

Notary Public.

My commission expires October 8, 1962

GRAYBOL OIL CORPORATION

Ellis County, Kansas

No. 1 Brull 60' W of SW NW

Section 20-13S-18W

Contractor; Company Tools

Elev: K.B. 2064' D.F. 2064'
G.L. 2059'

Commenced: August 25, 1962

Completed: September 3, 1962

Production: Dry & Abandoned

15.051.01475.00.00

CASING RECORD

177' of 8 5/8" casing cemented with 130 sacks cement.

<u>DEPTH</u>	<u>FORMATION</u>	<u>WELEX ELECTRIC LOG TOPS:</u>	
0-185	Surface sand and shale	ANHYDRITE	1370
185-690	Shale and shells	TOPEKA	3120
690-820	Shale	HEEBNER	3365
820-1040	Sand	TORONTO	3385
1040-1260	Shale and shells	LANSING	3412
1260-1367	Red bed and shale	BASE OF KANSAS CITY	3643
1367-1414	Anhydrite	ARBUCKLE	3736
1414-1440	Shale and Lime		
1440-2020	Shale and Shells		
2020-2079	Lime		
2079-2140	Lime and Shale		
2140-2195	Lime		
2195-2476	Shale and Lime		
2476-2605	Lime and Shale		
2605-2730	Shale and Shells		
2730-2975	Lime and Shale		
2975-3045	Shale and Lime		
3045-3160	Shale		
3160-3182	Lime		
3182-3511	Lime and Shale		
3511-3685	Lime		
3685-3745	Shale and Lime		
3745-3766	Lime and Shale		
3766-3772	Lime		

RECEIVED
STATE CORPORATION COMMISSION
SEP. 10 1962
CONSERVATION DIVISION
Wichita, Kansas

Driller's Total depth 3772'

Welex T.D. 3774'

I hereby certify that the above is a true and correct log of the above captioned well as taken directly from the daily drilling reports.

GRAYBOL OIL CORPORATION

BY: Lyman C. Dennis
Lyman C. Dennis, Geologist

STATE OF OKLAHOMA

COUNTY OF TULSA

Subscribed and sworn to the 6th day of September 1962.

My commission expires October 8, 1962

James Lawrence
NOTARY PUBLIC