

15-051-23573-00-00


STATE OF KANSAS
STATE CORPORATION COMMISSION

WELL PLUGGING RECORD

Give All Information Completely
Make Required Affidavit
Mail or Deliver Report to
Conservation Division
State Corporation Comm.
245 North Water
Wichita, KS 67202

Ellis County, Sec. 21 Twp. 13 Rge. 18 X/W
Location as "NE/CNW $\frac{1}{4}$ /SW $\frac{1}{4}$ " or footage from lines _____
NW NE SE

Lease Owner DaMar Oil Explorations
Lease Name T. Roth Well No. 1
Office Address P. O. Box 70, Hays, KS 67601
Character of Well (Completed as Oil, Gas or Dry Hole) _____
Dry Hole

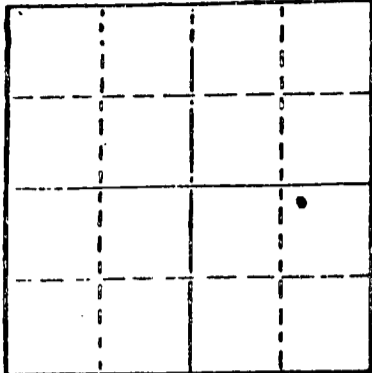

Locate well correctly on above
Section Plat

Date Well completed 8-21-19 83
Application for plugging filed 8-21-19 83
Application for plugging approved 8-21-19 83
Plugging commenced 8-21-19 83
Plugging completed 8-21-19 83
Reason for abandonment of well or producing formation _____

If a producing well is abandoned, date of last production _____ 19 _____

Was permission obtained from the Conservation Division or its agents before plugging was commenced? Yes

Name of Conservation Agent who supervised plugging of this well Marion Schmidt
Producing formation _____ Depth to top _____ Bottom _____ Total Depth of Well 3700'
Show depth and thickness of all water, oil and gas formations.

OIL, GAS OR WATER RECORDS

CASING RECORD

FORMATION	CONTENT	FROM	TO	SIZE	PUT IN	PULLED OUT
				8 5/8"	523'	-0-

Describe in detail the manner in which the well was plugged, indicating where the mud fluid was placed and the method or methods used in introducing it into the hold. If cement or other plugs were used, state the character of same and depth placed, from _____ feet to _____ feet for each plug set.

- 1st plug was set at 3660' with 20 sacks cement
- 2nd plug was set at 1410' with 20 sacks cement
- 3rd plug was set at 690' with 100 sacks cement
- 4th plug was set at 240' with 40 sacks cement
- 5th plug was set at 40' with 10 sacks cement

(If additional description is necessary, use BACK of this sheet)

Name of Plugging Contractor Dreiling Oil, Inc., Victoria, KS 67671


STATE OF KANSAS COUNTY OF ELLIS, ss.
Daniel F. Schippers (employee of owner) or (owner or operator)
of the above-described well, being first duly sworn on oath, says: That I have knowledge of the facts, statements, and matters herein contained and the log of the above-described well as filed and that the same are true and correct. So help me God.

(Signature)

P. O. Box 70, Hays, KS 67601
(Address)

SUBSCRIBED AND SWORN TO before me this 1st day of September, 1983

My commission expires _____

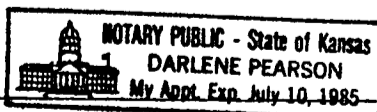

Darlene Pearson
Notary Public.

RECEIVED
STATE CORPORATION COMMISSION

SEP - 8 1983

CONSERVATION DIVISION
Wichita, Kansas