

15-051-23433-00-00

STATE OF KANSAS
STATE CORPORATION COMMISSION

WELL PLUGGING RECORD

Give All Information Completely
Make Required Affidavit
Mail or Deliver Report to
Conservation Division
State Corporation Comm.
245 North Water
Wichita, KS 67202

Ellis County, Sec. 21 Twp. 13S Rge. 18W E/W
Location as "NE/CNW $\frac{1}{4}$ SW $\frac{1}{4}$ " or footage from lines
SW NW NE

Lease Owner Mustang Drilling & Exploration, Inc.
Lease Name Pfannenstiel Well No. 1

Office Address 200 W. Douglas, Wichita, Kansas 67202
Character of Well (Completed as Oil, Gas or Dry Hole)

Dry Hole


Date Well completed May 4, 1983
Application for plugging filed May 4, 1983
Application for plugging approved May 4, 1983
Plugging commenced May 4, 1983
Plugging completed May 4, 1983

Reason for abandonment of well or producing formation
Dry Hole

If a producing well is abandoned, date of last production
19

Was permission obtained from the Conservation Division or
its agents before plugging was commenced? Yes

Name of Conservation Agent who supervised plugging of this well Marion Schmidt
Producing formation Depth to top Bottom Total Depth of Well 3675'
Show depth and thickness of all water, oil and gas formations.

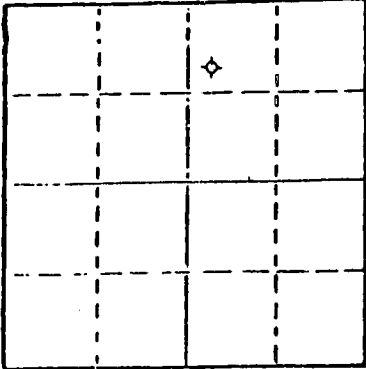

Locate well correctly on above
Section 71st

OIL, GAS OR WATER RECORDS

CASING RECORD

FORMATION	CONTENT	FROM	TO	SIZE	PUT IN	PULLED OUT

Describe in detail the manner in which the well was plugged, indicating where the mud fluid was placed and the method or methods used in introducing it into the hold. If cement or other plugs were used, state the character of same and depth placed, from feet to feet for each plug set.

Set 1st plug @ 3675' w/25 sxs

Set 2nd plug @ 1450' w/25 sxs

Set 3rd plug @ 750' w/70 sxs

Set 4th plug @ 420' w/40 sxs

Set 5th plug @ 40' w/10 sxs

10 sxs in the rat hole, total of 180 sxs 50/50 pozmix, 6% gel, 3% CC
plug down @ 10:45 PM 5-4-83

(If additional description is necessary, use BACK of this sheet)

Name of Plugging Contractor Union Drilling Co., Inc.

STATE OF Kansas COUNTY OF Sedgwick, ss.
R. D. Messinger (employee of owner) or (owner or operator)

of the above-described well, being first duly sworn on oath, says: That I have knowledge of the facts, statements, and matters herein contained and the log of the above-described well as filed and that the same are true and correct. So help me God.


(Signature) *R. D. Messinger*
422 Union Center, Wichita, Kansas 67202
(Address)

SUBSCRIBED AND SWORN TO before me this 9th day of May, 1983

Shirley A. Gallegos
Notary Public.

My commission expires 12-24-84

Shirley A. Gallegos

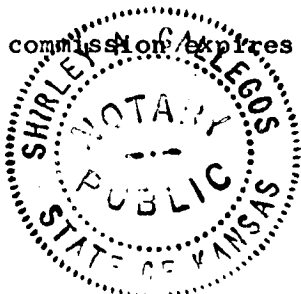

RECEIVED
STATE CORPORATION COMMISSION

MAY 24 1983

CONSERVATION DIVISION
Wichita, Kansas

CONTRACTOR'S WELL LOG

OPERATOR: Mustang Drilling & Exploration, Inc.
 CONTRACTOR: Union Drilling Co., Inc.
 LEASE NAME: Pfannenstiel #1
 LOCATION: SW NW NE Section 21-13S-18W
 Ellis County, Kansas
 COMMENCED: April 25, 1983
 COMPLETED: May 4, 1983

0	1383	Shale, Sand & Redbed	Set 8-5/8" @ 413' w/215 sxs common
1383	1447	Anhydrite	cement 2% gel, 3% CC
1447	2415	Shale	
2415	3408	Lime & Shale	
3408	3473	Lime	
3473	3675	Lime & Shale	
3675		RTD	

We certify that the above foregoing is a true and correct copy of the log on the Pfannenstiel #1, SW NW NE Section 21-13S-18W, Ellis County, Kansas.

Union Drilling Co., Inc.

R. D. Messinger
 R. D. Messinger

STATE OF KANSAS)
) SS
 COUNTY OF SEDGWICK)

Subscribed and sworn to before me, a Notary Public, in and for the aforesaid County and State as of this 9th day of May, 1983.

My appointment expires:
12-24-84

Shirley A. Gallegos
 Shirley A. Gallegos-Notary Public



RECEIVED
STATE CORPORATION COMMISSION

MAY 24 1983

CONSERVATION DIVISION
Wichita, Kansas