


15.051.30212.00.00
WELL PLUGGING RECORD

Give All Information Completely
Make Required Affidavit
Mail or Deliver Report to:
Conservation Division
State Corporation Commission
211 No. Broadway
Wichita, Kansas

Ellis County, Sec. 25 Twp. 13 Rge. (E) 18(W)
Location as "NE/CNW&SWK" or footage from lines NE SE NE
Lease Owner Woodman & Iannitti Drilling Co.
Lease Name Wasinger Well No. 1
Office Address 706 Union Nat'l. Bldg., Wichita, Kansas
Character of Well (completed as Oil, Gas or Dry Hole) Dry Hole
Date well completed 10-9 19 65
Application for plugging filed 10-9 19 65
Application for plugging approved 10-9 19 65
Plugging commenced 10-9 19 65
Plugging completed 10-9 19 65
Reason for abandonment of well or producing formation Dry

NORTH

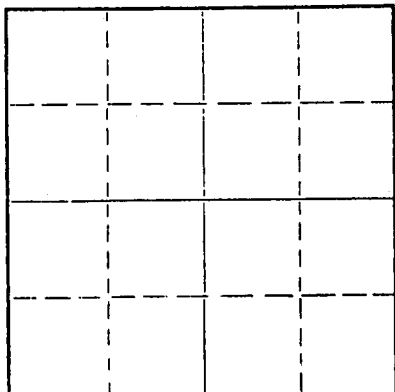

Locate well correctly on above
Section Plat

If a producing well is abandoned, date of last production 19
Was permission obtained from the Conservation Division or its agents before plugging was commenced? Yes

Name of Conservation Agent who supervised plugging of this well Eldon Petty
Producing formation Depth to top Bottom Total Depth of Well 3700 Feet
Show depth and thickness of all water, oil and gas formations.

OIL, GAS OR WATER RECORDS

CASING RECORD

FORMATION	CONTENT	FROM	TO	SIZE	PUT IN	PULLED OUT
				8 5/8	213'	

Describe in detail the manner in which the well was plugged, indicating where the mud fluid was placed and the method or methods used in introducing it into the hole. If cement or other plugs were used, state the character of same and depth placed, from feet to feet for each plug set.

Bottom Plug @ 540' w/20 sx.
Middle Plug @ 200' w/20 sx.
Top Plug @ 40' w/10 sx.

RECEIVED
STATE CORPORATION COMMISSION
OCT 12 1965
CONSERVATION DIVISION
Wichita, Kansas

(If additional description is necessary, use BACK of this sheet)
Name of Plugging Contractor Woodman & Iannitti Drilling Co.
Address 706 Union Nat'l. Bldg.

STATE OF Kansas, COUNTY OF Sedgwick, ss.
K. T. Woodman (employee of owner) or (owner or operator) of the above-described well, being first duly sworn on oath, says: That I have knowledge of the facts, statements, and matters herein contained and the log of the above-described well as filed and that the same are true and correct. So help me God.

(Signature) K. T. Woodman
K. T. Woodman
706 Union Nat'l. Bldg.
(Address)

SUBSCRIBED AND SWORN to before me this 11 day of October, 19 65

My commission expires Feb. 11, 1968

Justina Chamberlain
Justina Chamberlain Notary Public.

KANSAS GEOLOGICAL SOCIETY
KANSAS WELL LOG BUREAU - KANSAS WELL SAMPLE BUREAU
 KANSAS GEOLOGICAL SOCIETY BUILDING
 508 EAST MURDOCK - WICHITA, KANSAS

COMPANY Woodman & Iannitti Drilling Co.

SEC. 25 T. 13 R. 18W
 LOC. NE SE NE

FARM Wasinger NO. 1

TOTAL DEPTH 3700

COUNTY Ellis


COMM. Oct. 1, 1965

COMP. Oct. 9, 1965

SHOT OR TREATED

CONTRACTOR Woodman & Iannitti Drilling Co.

ISSUED

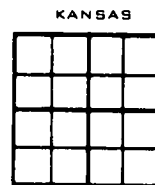

CASING

20	10
15	8 5/8 @ 213' w/130 sx.
12	6
13	5

ELEVATION 2145 KB

PRODUCTION D & A

FIGURES INDICATE BOTTOM OF FORMATIONS

60	Rock
213	Blue Shale
850	Shale
1060	Sand
1145	Shale
1375	Red Bed
1410	Anhy
1420	Anhy
1810	Shale
2070	Shale
2145	Lime & Shale
2310	Lime
2430	Lime
2520	Lime
2685	Lime
2810	Lime
2930	Lime
3075	Shale & Lime
3215	Lime & Shale
3288	Lime
3345	Lime
3385	Lime
3435	Lime
3505	Lime
3560	Lime
3585	Lime
3635	Lime
3685	Lime
3700	Lime
3700	Total Depth

I certify the above to be a true and correct copy of the drillers log and the geological tops to the best of my knowledge and belief.

WOODMAN & IANNITTI DRILLING CO.

By K. T. Woodman
 K. T. Woodman