


15087-03 6500-2
WELL PLUGGING RECORD

Give All Information Completely
Make Required Affidavit
Mail or Deliver Report to:
Conservation Division
State Corporation Commission
211 No. Broadway
Wichita, Kansas

Ellis County. Sec. 25 Twp. 13S Rge. (E) 18 (W)

Location as "NE/CNW/SW" or footage from lines SW NW NE
Lease Owner Clinton Oil Company
Lease Name WASINGER Well No. 1-X
Office Address 6810 West Highway U.S. 54, Wichita, Kansas
Character of Well (completed as Oil, Gas or Dry Hole) Dry Hole
Date well completed 5-30-64
Application for plugging filed verbal
Application for plugging approved verbal
Plugging commenced 5-30-64
Plugging completed 7:00 A.M., 5-30-64
Reason for abandonment of well or producing formation Dry

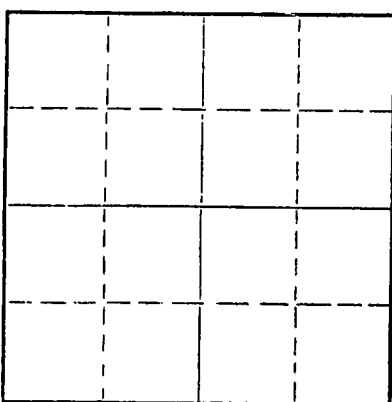

Locate well correctly on above Section Plat

If a producing well is abandoned, date of last production _____
Was permission obtained from the Conservation Division or its agents before plugging was commenced? yes

Name of Conservation Agent who supervised plugging of this well Eldon Petty, Hays, Kansas
Producing formation _____ Depth to top _____ Bottom _____ Total Depth of Well 3,700 Feet
Show depth and thickness of all water, oil and gas formations.

OIL, GAS OR WATER RECORDS

CASING RECORD

FORMATION	CONTENT	FROM	TO	SIZE	PUT IN	PULLED OUT
				8 5/8"	230'	

Describe in detail the manner in which the well was plugged, indicating where the mud fluid was placed and the method or methods used in introducing it into the hole. If cement or other plugs were used, state the character of same and depth placed, from _____ feet to _____ feet for each plug set.

Heavy mud to 540 feet through drill pipe. Placed wooden plug.
Added 20 sacks cement. Heavy mud to 210 feet through drill pipe.
Added 20 sacks cement. Heavy mud to 40 feet through drill pipe.
Placed wooden plug. Added 20 sacks cement to top of surface.
Bridged off rathole and added 3 sacks cement. Job completed
12:30 P.M., May 30, 1964.

RECEIVED
STATE CORPORATION COMMISSION
JUN 3 1964
6-3-64
CONSERVATION DIVISION
WICHITA, KANSAS

(If additional description is necessary, use BACK of this sheet)

Name of Plugging Contractor Sun Cementing Company
Address Box 169, Great Bend, Kansas

STATE OF KANSAS, COUNTY OF SEDGWICK, ss.
H. Marvin Douglass (employee of owner) or (~~owner or operator~~) of the above-described well, being first duly sworn on oath, says: That I have knowledge of the facts, statements, and matters herein contained and the log of the above-described well as filed and that the same are true and correct. So help me God.

(Signature) H. Marvin Douglass
6810 West Highway U.S. 54, Wichita, Kansas
(Address)

SUBSCRIBED AND SWORN TO before me this 1st day of June, 19 64

My commission expires July 16, 1967

Eldon E. Petty
Notary Public.

WELL LOG

15-057-01588-00-00

COMPANY **Clinton Oil Co**

SEC. **25 T. 13S R. 18W**

FARM **Wasinger**

NO. **1 - X**

LOC. **SW NW NE**

TOTAL DEPTH **3700'**


COUNTY **Ellis**

COMM. **5-21-64**

COMP. **5-30-64**

CONTRACTOR **Garvey Drilling Company**

CASING **8 5/8" @ 230' w/150 sx**

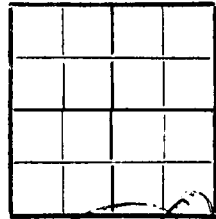

ELEVATION **2208' DE**

PRODUCTION **D & A**

FIGURES INDICATE BOTTOM OF FORMATIONS

- 40' Surface Soil and Rock
- 230' Blue Shale
- 780' Shale
- 980' Dakota Sand
- 1325' Red Bed and Gyp Streaks
- 1360' Anhydrite
- 1650' Shale and Shells
- 2300' Shale and Lime
- 2465' Lime
- 2675' Lime and Shale
- 2735' Shale and Lime
- 2915' Shale and Lime Streaks
- 3088' Shale and Lime
- 3165' Lime and Shale
- 3638' Lime
- 3700' Conglomerate
- 3700' RTD

RECEIVED
 STATE CORPORATION COMMISSION
 JUL 17 1964
 CONSERVATION DIVISION
 Topeka, Kansas

State of Kansas }
 County of Barton } SS

I, Sam N. Stephens of Garvey Drilling Company
 upon oath state the above and foregoing is a true and correct copy of the log of the Wasinger #1 - X well.

Sam N. Stephens

Subscribed and sworn to before me this 8th day of June 19 64

My Commission Expires: September 23rd, 1967

Howard C. Jones
 NOTARY PUBLIC