


15-051-22332-00-00

STATE OF KANSAS  
STATE CORPORATION COMMISSION

WELL PLUGGING RECORD

Give All Information Completely  
Make Required Affidavit  
Mail or Deliver Report to  
Conservation Division  
State Corporation Comm.  
245 North Water  
Wichita, KS 67202

Ellis County, Sec. 24 Twp. 13S Rge. 18W E/W  
Location as "NE/CNW $\frac{1}{4}$ SW $\frac{1}{4}$ " or footage from lines  
50' NE of NE SW NE  
Lease Owner K & E Drilling, Inc.  
Lease Name POLIFKA "B" #1 Well No. #1  
Office Address 816 Union Center, Wichita, KS 67202  
Character of Well (Completed as Oil, Gas or Dry Hole)  
Dry Hole

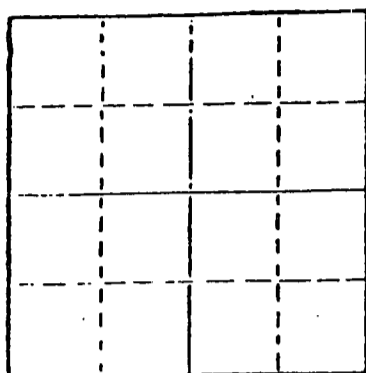

Locate well correctly on above  
Section Plot

Date Well completed April 1 1981  
Application for plugging filed April 1 1981  
Application for plugging approved April 1 1981  
Plugging commenced April 1 1981  
Plugging completed April 1 1981  
Reason for abandonment of well or producing formation  
No commercial quantity of oil or gas encountered.  
If a producing well is abandoned, date of last production  
19

Was permission obtained from the Conservation Division or  
its agents before plugging was commenced? yes

Name of Conservation Agent who supervised plugging of this well Dwayne Rankin  
Producing formation \_\_\_\_\_ Depth to top \_\_\_\_\_ Bottom \_\_\_\_\_ Total Depth of Well 3731'  
Show depth and thickness of all water, oil and gas formations.

OIL, GAS OR WATER RECORDS

CASING RECORD

FORMATION	CONTENT	FROM	TO	SIZE	PUT IN	PULLED OUT

Describe in detail the manner in which the well was plugged, indicating where the mud fluid  
was placed and the method or methods used in introducing it into the hold. If cement or other  
plugs were used, state the character of same and depth placed, from \_\_\_\_\_ feet to  
\_\_\_\_\_ feet for each plug set.

T.D. 3731'

Set 1st Plug @ 820' with 70 sx.

Set 2nd Plug @ 400' with 30 sx.

Set 3rd Plug @ 40' Solid Bridge with 10 sx.

Rathole with 5 sx., 50-50 posmix, 4% gel. 3% c.c.

Plug was down @ 1:15 p.m., 4/01/81.

State Plugger - Dwayne Rankin.

(If additional description is necessary, use BACK of this sheet)

Name of Plugging Contractor Abercrombie Drilling, Inc.

STATE OF Kansas COUNTY OF Sedgwick, ss.  
Jack L. Partridge, Vice President (employee of owner) or (owner or operator)  
of the above-described well, being first duly sworn on oath, says: That I have knowledge of  
the facts, statements, and matters herein contained and the log of the above-described well  
as filed and that the same are true and correct. So help me God.

(Signature) Jack L. Partridge  
801 Union Center, Wichita, KS 67202  
(Address)


SUBSCRIBED AND SWORN TO before me this 7th day of April, 19 81

My commission expires 2-4-85

Suzanne M. Hofer  
Suzanne M. Hofer Notary Public.

RECEIVED  
STATE CORPORATION COMMISSION

APR - 8 1981  
CONSERVATION DIVISION  
Wichita, Kansas

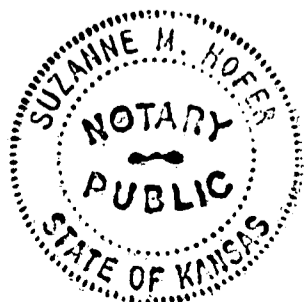

CONTRACTOR'S WELL LOG

15-051-22332-00-00

OPERATOR: K & E Drilling, Inc.  
 CONTRACTOR: Abercrombie Drilling, Inc.  
 WELL NAME: POLIFKA "B" #1  
 LOCATION: 50' NE of NE SW NE, Section 24-13S-18W  
 Ellis County, Kansas  
 SPUD DATE: 3/25/81  
 COMPLETION DATE: 4/01/81

0	1711	Sand & Shale
1711	3731	Shale & Lime
	3731	Rotary Total Depth

Spud @ 9:45 p.m., 3/25/81. Drilled 605' of a 12 $\frac{1}{2}$ " hole. Ran 15 jts. of 8 5/8" - 20# casing (tally 593.53) Set @ 603'. Cemented with 150 sx. of 50-50 posmix, 2% gel, 3% c.c. Followed with 150 sx. of common 2% gel, 3% c.c. Cement did circulate. Plug was down @ 10:45 p.m., 3/26/81.

T.D. @ 3731'. Set 1st Plug @ 820' with 70 sx. Set 2nd Plug @ 400' with 30 sx. Set 3rd Plug @ 40' Solid Bridge with 10 sx. Rathole with 5 sx. 50-50 posmix, 4% gel, 3% c.c. Plug was down @ 1:15 p.m., 4/01/81. State Plugger - Dwayne Rankin. Cement by Allied Cement.

SAMPLE TOPS:

Anhydrite 1385'  
 B/Anhydrite 1426'

STATE OF KANSAS )  
 ) SS  
 COUNTY OF SEDGWICK )

Jack L. Partridge, Vice President of Abercrombie Drilling, Inc., does hereby state that the above and foregoing is a true and correct copy of the log of the POLIFKA "B" #1, 50' NE of NE SW NE, Section 24-13S-18W, Ellis County, Kansas.

ABERCROMBIE DRILLING INC.

BY: Jack L. Partridge  
 Jack L. Partridge, Vice President

Subscribed and sworn to before me, a Notary Public, in and for the aforesaid county and state as of this 7th day of April, 1981.

2-4-85

Suzanne M. Hofer  
 Suzanne M. Hofer, Notary Public

