

This form shall be filed in duplicate with the Kansas Corporation Commission, 200 Colorado Derby Building, Wichita, Kansas 67202, within ten days after the completion of the well, regardless of how the well was completed.

Attach separate letter of request if the information is to be held confidential. If confidential, only file one copy. Information on side one will be of public record and side two will then be held confidential.

Circle one: Oil, Gas, Dry, SWD, OWWO, Injection. Type and complete ALL sections. Applications must be filed for dual completion, commingling, SWD and injection.

Attach wireline logs (i.e. electrical log, sonic log, gamma ray neutron log, etc.). KCC # (316) 263-3238. (Rules 82-2-105 & 82-2-125)

OPERATOR Graham-Michaelis Corporation
ADDRESS P. O. Box 247
Wichita, Kansas 67201

API NO. 15-051-22,651-00-00
COUNTY Ellis
FIELD Wildcat

\*\*CONTACT PERSON Jack L. Yinger
PHONE 264-8394

PROD. FORMATION Dry Hole
LEASE Kraus

PURCHASER None
ADDRESS


WELL NO. 1-13
WELL LOCATION 110' S of NE NE NE

DRILLING Revlin Drilling, Inc.
CONTRACTOR ADDRESS P. O. Box 88
Russell, Kansas 67665

220 Ft. from North Line and
330 Ft. from East Line of
the NE/4 SEC. 13 TWP. 13S RGE. 20W

PLUGGING Revlin Drilling, Inc.
CONTRACTOR ADDRESS P. O. Box 88
Russell, Kansas 67665

WELL PLAT

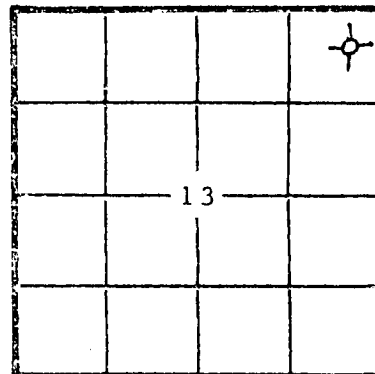

KCC
KGS
(Office Use)

TOTAL DEPTH 3790 PBD

SPUD DATE 10/14/81 DATE COMPLETED 10/22/81

ELEV: GR 2073 DF KB 2078

DRILLED WITH (CABLE) (ROTARY) (ANY) TOOLS

Amount of surface pipe set and cemented 335' DV Tool Used?

AFFIDAVIT

STATE OF Kansas, COUNTY OF Sedgwick, SS, I,

Jack L. Yinger OF LAWFUL AGE, BEING FIRST DULY SWORN UPON

DEPOSES THAT HE IS Vice President (FOR)(OF) Graham-Michaelis Corp.

OPERATOR OF THE Kraus LEASE, AND IS DULY AUTHORIZED TO MAKE

THIS AFFIDAVIT FOR AND ON THE BEHALF OF SAID OPERATOR, THAT WELL NO. 1-13 ON

SAID LEASE HAS BEEN COMPLETED AS OF THE 8th DAY OF December, 19 81, AND THAT

ALL INFORMATION ENTERED HEREIN WITH RESPECT TO SAID WELL IS TRUE AND CORRECT.

FURTHER AFFIANT SAITH NOT.

SUBSCRIBED AND SWORN BEFORE ME THIS 8th DAY OF December, 19 81.

ALDINE M. JOHNSON

NOTARY PUBLIC
STATE OF KANSAS

My Appointment Expires: 2-19-85

(S) Jack L. Yinger

Aldine M. Johnson
NOTARY PUBLIC

MY COMMISSION EXPIRES:

\*\*The person who can be reached by phone regarding any questions concerning this information. Within 45 days of completion, a witnessed initial test by the Commission is required if the well produces more than 25 BOPD or is located in a Basic Order Pool.

RECEIVED
STATE CORPORATION COMMISSION

DEC 10 1981

CONSERVATION DIVISION
Wichita, Kansas

12-10-81