15-051-01508-00-00

STATE OF KANSAS
STATE CORPORATION COMMISSION

Give All Information Completely
Make Required Affidavit
Mail or Deliver Report to:
Conservation Division
State Corporation Commission
800 Bitting Building
Wichita, Kansas

WELL PLUGGING RECORD

OR

FORMATION PLUGGING RECORD

Strike out upper line when reporting plugging off formations.

NORTH

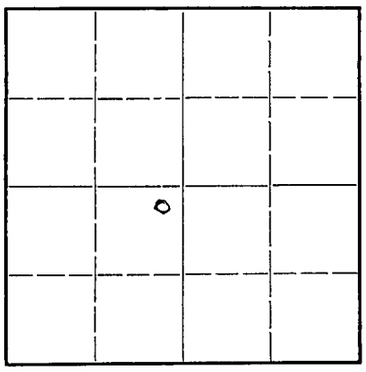

Locate well correctly on above Section Plat

Ellis County. Sec. 2 Twp. 13S Rge. 20W (E) (W)

Location as "NE¼NW¼SW¼" or footage from lines NE¼ NE¼ SW¼

Lease Owner: Continental Oil Co.

Lease Name: Snyder Well No. 1

Office Address: Ponca City, Oklahoma

Character of Well (completed as Oil, Gas or Dry Hole): Stratigraphic Test

Date well completed: June 3, 1944

Application for plugging filed: June 6, 1944

Application for plugging approved: June 6, 1944

Plugging commenced: June 7, 1944

Plugging completed: June 7, 1944

Reason for abandonment of well or producing formation:

If a producing well is abandoned, date of last production: 19

Was permission obtained from the Conservation Division or its agents before plugging was commenced? Yes

Name of Conservation Agent who supervised plugging of this well: Eldon Petty

Producing formation: Depth to top: Bottom: Total Depth of Well 3977 Feet

Show depth and thickness of all water, oil and gas formations.

OIL, GAS OR WATER RECORDS

CASING RECORD

Formation	Content	From	To	Size	Put In	Pulled Out
				8 5/8"	104'	None

Describe in detail the manner in which the well was plugged, indicating where the mud fluid was placed and the method or methods used in introducing it into the hold. If cement or other plugs were used, state the character of same and depth placed, from feet to feet for each plug set.

The hole was filled with heavy rotary mud to 550 feet where a wood plug was set and cemented thru the drill pipe with 15 sacks of cement. The hole was then filled with mud to 30' where a wood plug was set and cemented to the top of the hole.

2 13-20W
119 40

06-16-44

(If additional description is necessary, use BACK of this sheet)

Correspondence regarding this well should be addressed to: J. George Klein

Address: Box 120 Hays, Kansas

STATE OF Kansas, COUNTY OF Ellis, ss.

J. George Klein (employee of owner) or (~~owner or operator~~) of the above-described well, being first duly sworn on oath, says: That I have knowledge of the facts, statements, and matters herein contained and the log of the above-described well as filed and that the same are true and correct. So help me God.

(Signature) J. George Klein

Hays, Kans.
(Address)

SUBSCRIBED AND SWORN TO before me this 16 day of June, 1944

Alice M. Messman
Notary Public.

My commission expires July 13, 1946

20-1300-s 11-43—10M