


Give All Information Completely
Make Required Affidavit
Mail or Deliver Report to:
Conservation Division
State Corporation Commission
211 No. Broadway
Wichita, Kansas

15057-02863-00-00
WELL PLUGGING RECORD

ELLIS County. Sec. 2 Twp. 13S Rge. 20W (###) (W) X

Location as "NE/CNW&SW&" or footage from lines SE SW NW
Lease Owner: PETROLEUM, INC.
Lease Name: WERTH Well No. 2
Office Address: ROUTE 2, GREAT BEND, KANSAS
Character of Well (completed as Oil, Gas or Dry Hole) DRY HOLE

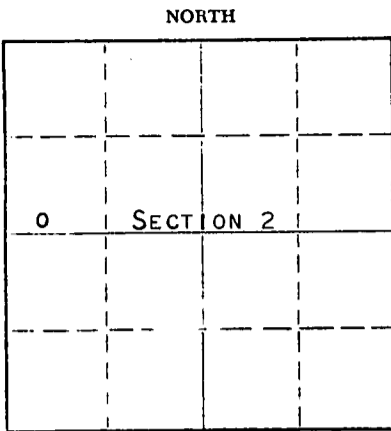

Locate well correctly on above Section Plat

Date well completed JANUARY 14, 19 59
Application for plugging filed OCTOBER 15, 19 62
Application for plugging approved OCTOBER 18, 19 62
Plugging commenced OCTOBER 29, 19 62
Plugging completed NOVEMBER 2, 19 62
Reason for abandonment of well or producing formation DEPLETION OF PRODUCIBLE FORMATIONS.

If a producing well is abandoned, date of last production SEPTEMBER 28, 19 62
Was permission obtained from the Conservation Division or its agents before plugging was commenced? YES

Name of Conservation Agent who supervised plugging of this well ELDON PETTY
Producing formation ARBUCKLE Depth to top 3823 Bottom ----- Total Depth of Well 3873' Feet
Show depth and thickness of all water, oil and gas formations.

OIL, GAS OR WATER RECORDS

CASING RECORD

| FORMATION | CONTENT | FROM | TO | SIZE | PUT IN | PULLED OUT |
|-----------|-----------------------------|-------|-------|------------------|---------------|------------------|
| ARBUCKLE | WATER & SMALL AMOUNT OF OIL | 3835' | 3843' | 8-5/8" 5-1/2" | 580' 3870' | NONE 2562.45' |
| | | | | | | |
| | | | | | | |
Describe in detail the manner in which the well was plugged, indicating where the mud fluid was placed and the method or methods used in introducing it into the hole. If cement or other plugs were used, state the character of same and depth placed, from _____ feet to _____ feet for each plug set.

PLUGGED BACK T.D. 3859'

FILLED HOLE WITH CRUSHED ROCK TO 3820'. RAN 4 SACKS CEMENT FROM 3820' TO 3790'. GLOBE CEMENTING COMPANY CIRCULATED 30 SACKS GEL AND PUMPED 20 SACKS CEMENT AT 600'. PULLED PIPE TO 180' AND PUMPED IN 20 SACKS CEMENT. PULLED REMAINING PIPE AND PLUGGED HOLE FROM 40' TO BASE OF WELL CELLAR WITH 10 SACKS CEMENT.

RECEIVED
STATE CORPORATION COMMISSION
11-12-62

CONSERVATION DIVISION
Wichita, Kansas

(If additional description is necessary, use BACK of this sheet)

Name of Plugging Contractor MORGAN WELL PLUGGING SERVICE
Address ROUTE 3, HUTCHINSON, KANSAS

STATE OF KANSAS, COUNTY OF BARTON, ss.
DON SEARLE (employee of owner) or (~~owner or operator~~) of the above-described well, being first duly sworn on oath, says: That I have knowledge of the facts, statements, and matters herein contained and the log of the above-described well as filed and that the same are true and correct. So help me God. DON SEARLE, DIST. PROD. SUPT.

(Signature) Don Searle
ROUTE 2, GREAT BEND, KANSAS
(Address)

SUBSCRIBED AND SWORN TO before me this 6TH day of NOVEMBER, 19 62

Arthur J. Vukobratovic
Notary Public.

My commission expires APRIL 14, 1963.



WELL LOG

COMPANY PETROLEUM, INCORPORATED

SEC. 2 T.13S R. 20W

FARM WERTH

NO. 2

LOC. SE, SW, NW

TOTAL DEPTH 3873'


15-051-02863-00-00

COUNTY ELLIS CO., KANSAS

COMM. December 15, 1958

COMP. December 28, 1958

CONTRACTOR GARVEY DRILLING COMPANY

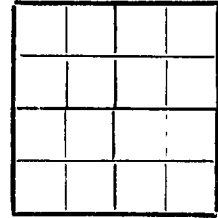

CASING 8 5/8" @ 580' W/300 sax.
5 1/2" @ 3870' W/100 sax.

ELEVATION 2162' DF

PRODUCTION ARBUCKLE

FIGURES INDICATE BOTTOM OF FORMATIONS

| | |
|------|--------------------------|
| 85 | Surface soil & post rock |
| 325 | Shale, sand & shells |
| 580 | Shale |
| 730 | Shale & red bed |
| 850 | Shale |
| 1245 | Red bed & sand |
| 1495 | Red bed & shale |
| 1525 | Anhydrite |
| 1740 | Shale & shells |
| 2460 | Shale |
| 3316 | Lime & shale |
| 3790 | Lime |
| 3822 | Conglomerate |
| 3873 | Lime |
| 3873 | T. D. |

RECORDED
STATE COMMISSION

CONSERVED
WELL

State of KANSAS }
County of BARTON } ss:

I, VERNE A. MORRIS of GARVEY DRILLING COMPANY
upon oath state that the above and foregoing is a true and correct copy of the log of the #2 WERTH well

Subscribed and sworn to before me this 3rd day of March 19 59

My Commission Expires: July 11, 1960

Verne A. Morris
Del. J. Brown
NOTARY PUBLIC

PETROLEUM, INC.

ROUTE 2
 GREAT BEND, KANSAS
 OCTOBER 15, 1962

MORGAN WELL PLUGGING SERVICE
 MR. BILL MORGAN
 ROUTE 3
 HUTCHINSON, KANSAS

15051-02863-0000

DEAR MR. MORGAN:

THE FOLLOWING IS INFORMATION YOU WILL NEED IN THE PIPE PULLING AND PLUGGING OF ONE OF OUR ABANDONED WELLS:

| | |
|--------------------------|---|
| WELL: | WERTH #2 |
| DESCRIPTION: | SE SW NW, SEC. 2-13s-20W ELLIS COUNTY, KANSAS |
| ROTARY TOTAL DEPTH: | 3873' |
| PRESENT TOTAL DEPTH: | 3859' |
| SURFACE CASING: | 8-5/8" OD 19.64# CASING SET AT 380' WITH 300 SACKS CEMENT, 2% GEL, 2% CC. |
| PRODUCTION STRING: | 5 1/2" OD BRD 14# J-55 CLASS "A" CASING SET AT 3870' WITH 100 SACKS POZMIX, 2% GEL ON 12-28-58. |
| TEMPERATURE SURVEY: | TOP OF CEMENT AT 3380' |
| TOP CASING PERFORATIONS: | 3835'-3843' |

PLEASE NOTIFY US AS TO WHEN YOU WILL MOVE ONTO THIS LOCATION.

VERY TRULY YOURS,
 PETROLEUM, INC.

Don Searle
 DON SEARLE
 DIST PROD. SUPT.

DS/MM

CC: ELDON PETTY, Box 326, HAYS, KANSAS
 C. J. WILTSE
 MONTE CHADD
 LAWRENCE PROFFITT
 FILE (2)