


STATE OF KANSAS  
STATE CORPORATION COMMISSION

Give All Information Completely  
Make Required Affidavit  
Mail or Deliver Report to:  
Conservation Division  
State Corporation Commission  
212 North Market, Insurance Bldg.  
Wichita, Kansas

15-051-04302-00-00  
**WELL PLUGGING RECORD**

NORTH

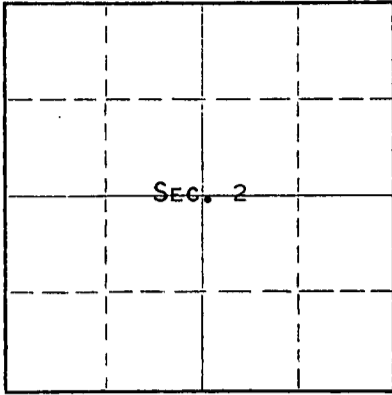

Locate well correctly on above  
Section Plat

ELLIS County. Sec. 2 Twp. 13S Rge. 20W (~~E~~) X (W)  
Location as "NE/CNW/SW" or footage from lines SE NW NW  
Lease Owner PETROLEUM, INC.  
Lease Name WERTH Well No. 3  
Office Address ROUTE 2, GREAT BEND, KANSAS  
Character of Well (completed as Oil, Gas or Dry Hole) DRY HOLE  
Date well completed JUNE 26, 1960  
Application for plugging filed JUNE 26, 1960  
Application for plugging approved JUNE 26, 1960  
Plugging commenced JUNE 26, 1960  
Plugging completed JUNE 26, 1960  
Reason for abandonment of well or producing formation NO PRODUCING ZONES

If a producing well is abandoned, date of last production NONE 19     
Was permission obtained from the Conservation Division or its agents before plugging was commenced? YES

Name of Conservation Agent who supervised plugging of this well ELDON PETTY  
Producing formation ---- Depth to top -- Bottom --- Total Depth of Well 3876 Feet  
Show depth and thickness of all water, oil and gas formations.

OIL, GAS OR WATER RECORDS

CASING RECORD

FORMATION	CONTENT	FROM	TO	SIZE	PUT IN	PULLED OUT
				8-5/8"	602'	NONE

Describe in detail the manner in which the well was plugged, indicating where the mud fluid was placed and the method or methods used in introducing it into the hole. If cement or other plugs were used, state the character of same and depth placed, from \_\_\_\_\_ feet to \_\_\_\_\_ feet for each plug set.

MUDDED UP WITH HEAVY MUD TO 580' FOLLOWED BY WOODEN PLUG. PLACED 20 SACKS CEMENT THROUGH DRILL PIPE ON TO PLUG. MUDDED UP WITH HEAVY MUD TO 180' FOLLOWED BY WOODEN PLUG. PLACED 20 SACKS CEMENT THROUGH DRILL PIPE ON TO PLUG. MUDDED UP WITH HEAVY MUD TO 40' FOLLOWED BY WOODEN PLUG AND 10 SACKS OF CEMENT TO BASE OF WELL COLLAR.

**RECEIVED**  
STATE CORPORATION COMMISSION  
JUL 11 1960  
CONSERVATION DIVISION  
Wichita, Kansas

(If additional description is necessary, use BACK of this sheet)  
Name of Plugging Contractor JONES DRILLING COMPANY  
Address 1021 MCKINLEY, GREAT BEND, KANSAS

STATE OF KANSAS, COUNTY OF BARTON, ss.  
DON SEARLE (employee of owner) or (owner or operator) of the above-described well, being first duly sworn on oath, says: That I have knowledge of the facts, statements, and matters herein contained and the log of the above-described well as filed and that the same are true and correct. So help me God.

(Signature) Don Searle  
ROUTE 2, GREAT BEND, KANSAS  
(Address)

SUBSCRIBED AND SWORN TO before me this 7TH day of JUNE, 1960

Arthur J. Mule  
Notary Public.

My commission expires APRIL 14, 1963



WELL LOG

Date started 6-14-60  
Date completed 6-26-60

15-751-04302-00-00  
Werth #3  
990' South of the North line,  
990' East of the West line  
Sec. 2-13-20  
Ellis County, Kansas

Topeka	3,210'
Hebiner	3,442'
Toronto	3,460'
Kansas City	3,480'
Base of Kansas City	3,735'
Mississippi	3,759'
Churt	3,786'
Conglomerate	3,817'
Arbuckle	3,856'
Total Depth	3,876'

- 0' - 475' Shale and shells
- 475' - 585' Sand and shells
- 585' - 1060' Shale and shells
- 1060' - 1505' Shale, sand and shells
- 1505' - 1540' Anhydrite
- 1540' - 2100' Shale and shells
- 2100' - 2200' Sandy lime and shale
- 2200' - 3250' Lime and shale
- 3250' - 3300' lime, shale and chenty
- 3300' - 3375' Lime and shale
- 3375' - 3435' Lime
- 3435' - 3475' Lime and shale
- 3475' - 3680' Lime
- 3680' - 3735' Lime and shale
- 3735' - 3785' Lime
- 3785' - 3863' Lime and shale
- 3863' - 3876' Arbuckle

AFFIDAVIT

State of Kansas . . . . . County of Barton

I, A. M. Jones, certify that the above is a true and correct log as reflected by the Daily Drilling Reports of the Jones Drilling Company.

By A. M. Jones  
A. M. Jones Owner

Subscribed and sworn before me this 1st day of July, 1960.

John W. Poo  
Notary Public John W. Poo

My commission expires April 11, 1963

RECEIVED  
COMMISSION  
JULY 1960  
COMMISSION