


STATE OF KANSAS  
STATE CORPORATION COMMISSION

15-051-21755-0000  
WELL PLUGGING RECORD

Give All Information Completely  
Make Required Affidavit  
Mail or Deliver Report to  
Conservation Division  
State Corporation Comm.  
245 North Water  
Wichita, KS 67202

Ellis County, Sec. 2 Twp. 13 Rge. 20W E/W  
Location as "NE/CNW $\frac{1}{4}$ SW $\frac{1}{4}$ " or footage from lines  
SE SE SW

Lease Owner Tomlinson Oil Company  
Lease Name Dortzweiler Well No. 1  
Office Address 200 W. Douglas, Ste. 1030, Wichita, KS  
Character of Well (Completed as Oil, Gas or Dry Hole)  
Dry Hole

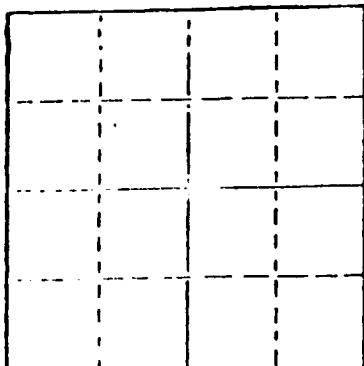

Locate well correctly on above  
Section Plat

Date Well completed Sep. 02 19 79  
Application for plugging filed (verbally) Sep. 02 19 79  
Application for plugging approved (verbally) Sep. 02 19 79  
Plugging commenced Sep. 02 19 79  
Plugging completed Sep. 02 19 79  
Reason for abandonment of well or producing formation  
No commercial quantity of oil or gas encountered  
If a producing well is abandoned, date of last production  
19

Was permission obtained from the Conservation Division or  
its agents before plugging was commenced? Yes

Name of Conservation Agent who supervised plugging of this well Marion Schmidt  
Producing formation \_\_\_\_\_ Depth to top \_\_\_\_\_ Bottom \_\_\_\_\_ Total Depth of Well 3500'  
Show depth and thickness of all water, oil and gas formations.

OIL, GAS OR WATER RECORDS

CASING RECORD

FORMATION	CONTENT	FROM	TO	SIZE	PUT IN	PULLED OUT

Describe in detail the manner in which the well was plugged, indicating where the mud fluid  
was placed and the method or methods used in introducing it into the hold. If cement or other  
plugs were used, state the character of same and depth placed, from \_\_\_\_\_ feet to  
\_\_\_\_\_ feet for each plug set.

T.D. 3500'

Set 1st plug at 865' with 60 sacks  
2nd plug at 215' with 30 sacks  
3rd plug at 40' solid bridge with 10 sacks  
rathole with 5 sacks.

Cemented with 50/50 posmix, 6% gel.  
Plug was down at 3:00 p.m., 09-02-79.

RECEIVED  
STATE CORPORATION COMMISSION

SEP - 6 1979

CONSERVATION DIVISION  
Wichita, Kansas

(If additional description is necessary, use BACK of this sheet)

Name of Plugging Contractor Abercrombie Drilling, Inc.

STATE OF Kansas COUNTY OF Sedgwick, ss.  
Jack L. Partridge, Asst. Sec.-Treas. (employee of owner) or (owner or operator)  
of the above-described well, being first duly sworn on oath, says: That I have knowledge of  
the facts, statements, and matters herein contained and the log of the above-described well  
as filed and that the same are true and correct. So help me God.

(Signature) Jack L. Partridge  
801 Union Center, Wichita, Kansas  
(Address)

SUBSCRIBED AND SWORN TO before me this 5th day of September, 1979



My commission expires 08-21-82

Sherrie L. Brooks  
Sherrie L. Brooks Notary Public.

CONTRACTOR'S WELL LOG

15-051-0175-300000

OPERATOR: Tomlinson Oil Company  
 CONTRACTOR: Abercrombie Drilling, Inc.  
 WELL NAME: Dortzweiler #1  
 LOCATION: SE SE SW, Section 2-13-20  
 Ellis County, Kansas  
 SPUD DATE: August 29, 1979  
 COMPLETION DATE: September 02, 1979

0	225	Sandstone and shale
225	635	Shale and sand
635	960	Shale
960	1170	Sand
1170	1478	Shale
1478	1528	Anhydrite
1528	2015	Shale
2015	3483	Shale and lime
3483	3500	Lime
	3500	Rotary Total Depth

Spud hole at 11:15 a.m., August 29, 1979. Drilled 225' of 12 1/4" hole. Ran 5 joints of 8-5/8" new casing. Set at 222' with 160 sacks of common cement, 3% Ca.Cl., 2% gel. Cement did circulate. Plug was down at 3:45 p.m., August 29, 1979.

T.D. 3500'. Set 1st plug at 865' with 60 sacks, 2nd plug at 215' with 30 sacks, 3rd plug at 40' solid bridge with 10 sacks, rathole with 5 sacks. Cemented with 50/50 posmix, 6% gel. Job was complete at 3:00 p.m., September 02, 1979.

SAMPLE TOPS:

Anhydrite 1478'  
 B/Anhydrite 1528'

STATE OF KANSAS )  
 ) ss  
 COUNTY OF SEDGWICK )

RECEIVED  
 STATE CORPORATION COMMISSION

SEP 11 1979

CONSERVATION DIVISION  
 Wichita, Kansas

Jack L. Partridge, Assistant Secretary-Treasurer of Abercrombie Drilling, Inc., does hereby state that the above and foregoing is a true and correct copy of the log of the Dortzweiler #1, SE SE SW, Section 2-13-20, Ellis County, Kansas.

ABERCROMBIE DRILLING, INC.

BY Jack L. Partridge  
 Jack L. Partridge  
 Assistant Secretary-Treasurer

Subscribed and sworn to before me, a Notary Public, in and for the county and state aforesaid, as of this 5th day of September, 1979.



Sherrie L. Brooks  
 Sherrie Brooks, Notary Public

My commission expires 08-21-82.