


Give All Information Completely
Make Required Affidavit
Mail or Deliver Report to:
Conservation Division
State Corporation Commission
211 No. Broadway
Wichita, Kansas

15-057-64301-00-00
WELL PLUGGING RECORD

Ellis County. Sec. 2 Twp. 13S Rge. (E) 20 (W)
Location as "NE/CNW/SW" or footage from lines. NE NW SW

Lease Owner Robinowitz Oil Company
Lease Name Dorzweiler Well No. 1
Office Address 311 Shell Bldg., Tulsa, Okla.
Character of Well (completed as Oil, Gas or Dry Hole) Dry Hole
Date well completed 12-29-1962
Application for plugging filed 12-29-1962
Application for plugging approved 12-29-1962
Plugging commenced 12-29-1962
Plugging completed 12-29-1962
Reason for abandonment of well or producing formation Dry Hole

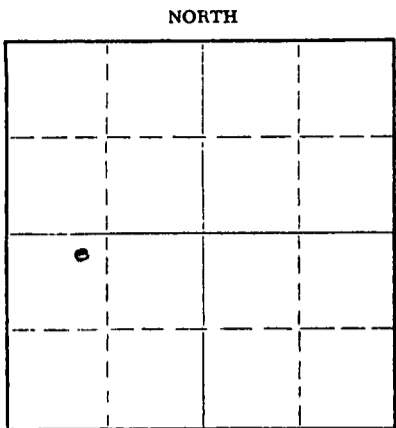

Locate well correctly on above Section Plat

If a producing well is abandoned, date of last production _____ 19____
Was permission obtained from the Conservation Division or its agents before plugging was commenced? Yes

Name of Conservation Agent who supervised plugging of this well Gilbert Lieker
Producing formation Dry Hole Depth to top _____ Bottom _____ Total Depth of Well 3849 Feet
Show depth and thickness of all water, oil and gas formations.

OIL, GAS OR WATER RECORDS

CASING RECORD

FORMATION	CONTENT	FROM	TO	SIZE	PUT IN	PULLED OUT
Lansing	Mud	3463	3722	8-5/8"	611'	None

Describe in detail the manner in which the well was plugged, indicating where the mud fluid was placed and the method or methods used in introducing it into the hole. If cement or other plugs were used, state the character of same and depth placed, from _____ feet to _____ feet for each plug set.

Bottom plug at 580' w/20 cement through drill pipe
Top plug at 40' w/1/2 sk hulls and 10 cement

RECEIVED
STATE CORPORATION COMMISSION

JAN 8 1963

CONSERVATION DIVISION
Wichita, Kansas

(If additional description is necessary, use BACK of this sheet)
Name of Plugging Contractor Rotary well drilled - no pipe set
Address _____

STATE OF Oklahoma, COUNTY OF Tulsa, ss.
Joseph Teichman (employee of owner) or (owner or operator) of the above-described well, being first duly sworn on oath, says: That I have knowledge of the facts, statements, and matters herein contained and the log of the above-described well as filed and that the same are true and correct. So help me God.

(Signature) Joseph Teichman
P.O. Box 7027, Tulsa, Oklahoma
(Address)

SUBSCRIBED AND SWORN TO before me this 31st day of December, 1962

Vernie Hunter
Notary Public.

My commission expires 3-17-64



SHOLOM DRILLING COMPANY, INC.

P.O. BOX 7027
Tulsa, Oklahoma

FORMATION LOG

COMPANY: Robinowitz Oil Company
FARM: DORZWEILER #1
LOCATION: NE NW SW Sec. 2 T13S R20W - Ellis County, Kansas
ROTARY DRILLING CONTRACTOR: Sholom Drilling Company, Inc.

COMMENCED: 12-16-62
COMPLETED: 12-29-62
I. P.: D & A

Elevation: 2159' K.B.
Rotary TD: 3849'

Casing Record:
8-5/8" @ 611' w/300 sax

L O G

0 -	50	Post Rock
50 -	200	Shells
200 -	250	Shale & Shells
250 -	400	Sand
400 -	500	Shale & Sand
500 -	550	Sand
550 -	566	Shale
566 -	611	Plug & Cement
611 -	800	Shale & Shells
800 -	980	Sand w/Hard Sand Streaks
980 -	1190	Sand
1190 -	1230	Shale
1230 -	1489	Red Bed
1489 -	1539	Anhydrite
1539 -	2000	Shale & Shells
2000 -	2080	Shale & Lime
2080 -	3300	Lime & Shale
3300 -	3416	Lime
3416 -	3463	Lime & Shale
3463 -	3750	Lime
3750 -	3800	Lime & Shale
3800 -	3849	Lime & Chert

DST #1 3431-3528
Rec. 20' mud w/specks of oil

DST #2 3581-3725
Rec. 450' watery mud

Anhydrite	1489-1539'
Topeka	3191'
Heebner	3424'
Toronto	3446'
Lansing	3463'
Base of K.C.	3722'
Marmaton	3764'
Conglomerate	3806'
Rotary T.D.	3849'

RECEIVED
STATE CORPORATION COMMISSION

JAN 8 1963

CONSERVATION DIVISION
Wichita, Kansas

STATE OF OKLAHOMA)
COUNTY OF TULSA) ss.

I, Joseph Teichman, President of Sholom Drilling Company, Inc. a corporation of the State of Oklahoma, domesticated in the State of Kansas, being first duly sworn under oath, says: That I have knowledge of the facts, statements and matters herein contained of the above described well as filed and that the same are true and correct.


Joseph Teichman

Subscribed and sworn to before me this 7th day of January, 1963.


Notary Public

My commission expires: 3-17-64