


STATE OF KANSAS
STATE CORPORATION COMMISSION

15-05122112-00-10
WELL PLUGGING RECORD

Give All Information Completely
Make Required Affidavit
Mail or Deliver Report to
Conservation Division
State Corporation Comm.
245 North Water
Wichita, KS 67202

Ellis County, Sec. 20 Twp. 13S Rge. 19 E/W
Location as "NE/CNW $\frac{1}{4}$ SW $\frac{1}{4}$ " or footage from lines
SW NE NE
Lease Owner K & E Drilling, Inc.
Lease Name BEMIS Well No. 1
Office Address 816 Union Center, Wichita, KS
Character of Well (Completed as Oil, Gas or Dry Hole)

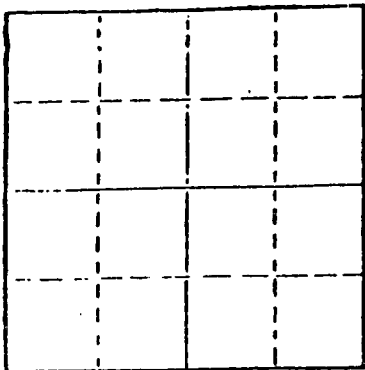

Locate well correctly on above
Section Plot

Dry Hole
Date Well completed 10-30 19 80
Application for plugging filed 10-30 19 80
Application for plugging approved 10-30 19 80
Plugging commenced 10-30 19 80
Plugging completed 10-30 19 80
Reason for abandonment of well or producing formation
No commercial quantity of oil or gas available
If a producing well is abandoned, date of last production 19

Was permission obtained from the Conservation Division or
its agents before plugging was commenced? Yes

Name of Conservation Agent who supervised plugging of this well Marion Schmidt
Producing formation _____ Depth to top _____ Bottom _____ Total Depth of Well 3820'
Show depth and thickness of all water, oil and gas formations.

OIL, GAS OR WATER RECORDS

CASING RECORD

FORMATION	CONTENT	FROM	TO	SIZE	PUT IN	PULLED OUT

Describe in detail the manner in which the well was plugged, indicating where the mud fluid
was placed and the method or methods used in introducing it into the hold. If cement or other
plugs were used, state the character of same and depth placed, from _____ feet to
_____ feet for each plug set.

T.D. 3820'

Set 1st plug @ 930' with 70 sx.
2nd plug @ 370' with 25 sx.
3rd plug @ 40' solid bridge with 10 sx.
Rathole with 5 sx.

RECEIVED
STATE CORPORATION COMMISSION

Plug was down @ 12:30 a.m. 10-30-80.

NOV - 5 1980

CONSERVATION DIVISION
Wichita, Kansas

(If additional description is necessary, use BACK of this sheet)

Name of Plugging Contractor Abercrombie Drilling, Inc.

STATE OF Kansas COUNTY OF Sedgwick', ss.
Jack L. Partridge, Asst. Sec.-Treas. (employee of owner) or (owner or operator)
of the above-described well, being first duly sworn on oath, says: That I have knowledge of
the facts, statements, and matters herein contained and the log of the above-described well
as filed and that the same are true and correct. So help me God.

(Signature)

Jack L. Partridge

801 Union Center, Wichita, Kansas 67202
(Address)

SUBSCRIBED AND SWORN TO before me this 31st day of October, 19

Jeanette A. Metheny
Jeanette A. Metheny Notary Public.

My commission expires 08-18-84



CONTRACTOR'S WELL LOG

15.051.22112.00.00

OPERATOR: K & E Drilling, Inc.
 CONTRACTOR: Abercrombie Drilling, Inc.
 WELL NAME: BEMIS #1
 LOCATION: SW NE NE, Sec. 20-13S-19W
 Ellis County, Kansas
 SPUD DATE: 10-21-80
 COMPLETION DATE: 10-30-80

0	1400	Sand & Shale
1400	1446	Anhydrite
1446	1569	Sand & Shale
1569	2387	Shale & Lime
2387	2634	Shale & Sand
2634	3820	Shale & Lime
	3820	Rotary Total Depth

Spud hole @ 3:15 p.m. 10-21-80. Drilled 300' of a 12-1/4" hole. Ran 7 joints of 8-5/8" 24# used casing (tally 290.41') Set @ 296.91'. Cemented with 185 sx. of common, 2% gel, 3% c.c. Plug was down @ 11:15 p.m. 10-21-80.

T.D. 3820'. Set 1st plug @ 930' with 70 sx., 2nd plug @ 370' with 25 sx., 3rd plug @ 40' solid bridge with 10 sx. Rathole with 5 sx. Plug was down @ 12:30 a.m. 10-30-80.

SAMPLE TOPS:

Anhydrite 1400'
 B/Anhydrite 1446'

RECEIVED
 STATE CORPORATION COMMISSION

NOV - 5 1980

CONSERVATION DIVISION
 Wichita, Kansas

STATE OF KANSAS)
) SS
 COUNTY OF SEDGWICK)

Jack L. Partridge, Assistant Secretary-Treasurer of abercrombie Drilling, Inc., does hereby state that the above and foregoing is a true and correct copy of the log of the BEMIS #1, SW NE NE, Section 20-13S-19W, Ellis County, Kansas.

ABERCROMBIE DRILLING, INC.

BY Jack L. Partridge
 JACK L. Partridge, Asst. Sec.-Treas

Subscribed and sworn to before me, a Notary Public, in and for the aforesaid county and state as of this 31st day of October, 1980.

Jeanette A. Metheny
 Jeanette A. Metheny, Notary Public

