


STATE OF KANSAS
STATE CORPORATION COMMISSION

Give All Information Completely
Make Required Affidavit
Mail or Deliver Report to:
Conservation Division
State Corporation Commission
212 North Market, Insurance Bldg.
Wichita, Kansas

15-051-1966-00-01
WELL PLUGGING RECORD

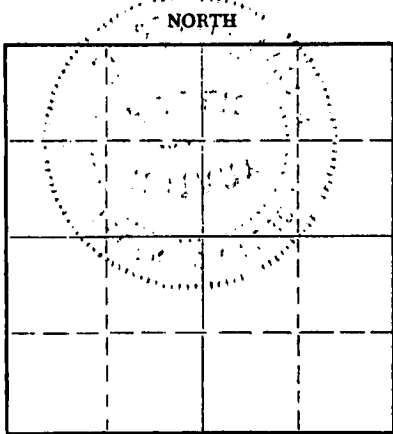

Locate well correctly on above Section Plat

Ellis County, Sec. 20 Twp. 13s Rge. 19w (E) (W)
Location as "NE/CNWxSWx" or footage from lines NW, NW, NE,
Lease Owner John O. Farmer, Inc.
Lease Name Guy Bemis Well No. 2
Office Address P.O. Box 352, Russell, Kansas 67665
Character of Well (completed as Oil, Gas or Dry Hole) Oil
Date well completed 4/22 1967
Application for plugging filed 9/27 1968
Application for plugging approved 9/30 1968
Plugging commenced 9/30 1968
Plugging completed 10/3 1968
Reason for abandonment of well or producing formation No fluid

If a producing well is abandoned, date of last production _____ 19____
Was permission obtained from the Conservation Division or its agents before plugging was commenced? Yes

Name of Conservation Agent who supervised plugging of this well Leo Massey, Hays, Kansas
Producing formation Lansing Depth to top _____ Bottom _____ Total Depth of Well 3782 Feet
Show depth and thickness of all water, oil and gas formations.

OIL, GAS OR WATER RECORDS

CASING RECORD

FORMATION	CONTENT	FROM	TO	SIZE	PUT IN	PULLED OUT

Describe in detail the manner in which the well was plugged, indicating where the mud fluid was placed and the method or methods used in introducing it into the hole. If cement or other plugs were used, state the character of same and depth placed, from _____ feet to _____ feet for each plug set.

Globe Cementing Pumped 25 sx. gel & 5 sx. hulls
& 130 sx. cement.
Completed: 10/3/68
Leo Massey, State plugger

RECEIVED
STATE CORPORATION COMMISSION
OCT 8 - 1968
CONSERVATION DIVISION
Wichita, Kansas

(If additional description is necessary, use BACK of this sheet)
Name of Plugging Contractor Ralph Comstock Pipe Pulling, Inc.
Address 320 North Park, Stafford, Kansas 67578

STATE OF KANSAS, COUNTY OF RUSSELL, ss.
JOHN O. FARMER, Pres. (employee of owner) or (owner or operator) of the above-described well, being first duly sworn, on oath, says: That I have knowledge of the facts, statements, and matters herein contained and the log of the above-described well as filed and that the same are true and correct. So help me God.

(Signature) John O. Farmer
P.O. Box 352, Russell, Kansas (Address)

Subscribed and sworn to before me this 7th day of October, 1968

My commission expires February 15, 1971

Helen Carlson
Notary Public.