

15:051.01287.00.00  
**WELL PLUGGING RECORD**

Give All Information Completely  
Make Required Affidavit  
Mail or Deliver Report to:  
Conservation Division  
State Corporation Commission  
211 No. Broadway  
Wichita, Kansas

**Ellis**

County. Sec. 30 Twp. 13 Rge. (E)19 (W)

Location as "NE/CNW&SW" or footage from lines SW SW NE

Lease Owner Stickle Drilling Company

Lease Name MARTIN

Well No. 1

Office Address 1027 Union Center, Wichita 2, Kansas

Character of Well (completed as Oil, Gas or Dry Hole) Dry Hole

Date well completed 30 April 1957

Application for plugging filed 30 April 1957

Application for plugging approved 30 April 1957

Plugging commenced 30 April 1957


Plugging completed 30 April 1957

Reason for abandonment of well or producing formation Dry Hole

If a producing well is abandoned, date of last production \_\_\_\_\_ 19\_\_\_\_

Was permission obtained from the Conservation Division or its agents before plugging was commenced? Yes

NORTH

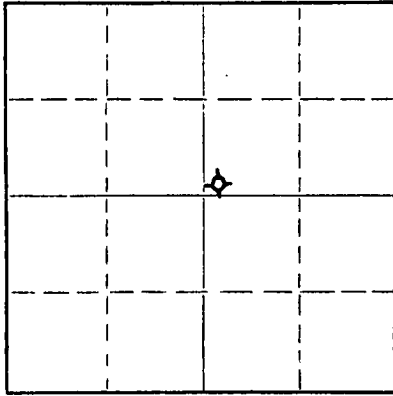

Locate well correctly on above Section Plat

Name of Conservation Agent who supervised plugging of this well Eldon Petty, Hays, Kansas

Producing formation \_\_\_\_\_ Depth to top \_\_\_\_\_ Bottom \_\_\_\_\_ Total Depth of Well 3965 Feet

Show depth and thickness of all water, oil and gas formations.

OIL, GAS OR WATER RECORDS

CASING RECORD

FORMATION	CONTENT	FROM	TO	SIZE	PUT IN	PULLED OUT
<u>Sand and Gravel</u>	<u>water</u>	<u>0</u>	<u>200'</u>	<u>8 5/8"</u>	<u>208'</u>	<u>None</u>

Describe in detail the manner in which the well was plugged, indicating where the mud fluid was placed and the method or methods used in introducing it into the hole. If cement or other plugs were used, state the character of same and depth placed, from \_\_\_\_\_ feet to \_\_\_\_\_ feet for each plug set.

Mixed mud in pits thoroughly with jets and placed heavy rotary mud from total depth to 600 feet through drill pipe.

A wooden plug and 1/2 sack of hulls were placed at 600 feet with 35 sacks of cement placed on top of this through the drill pipe.

Heavy rotary mud was placed to 40 feet.

A wooden plug and 1/2 sack of hulls were placed at 40 feet with 15 sacks of cement placed on top of this through the drill pipe.

(If additional description is necessary, use BACK of this sheet)

Name of Plugging Contractor Stickle Drilling Company

Address 1027 Union Center, Wichita 2, Kansas

STATE OF KANSAS, COUNTY OF SEDGWICK, ss.

Clifford M. Smith

(employee of owner) or (~~owner of property~~) of the above-described

well, being first duly sworn on oath, says: That I have knowledge of the facts, statements, and matters herein contained and the log of the above-described well as filed and that the same are true and correct. So help me God.

(Signature)

Clifford M. Smith

1027 Union Center, Wichita 2, Kansas

(Address)

SUBSCRIBED AND SWORN to before me this 2nd

**RECEIVED**  
STATE CORPORATION COMMISSION

May, 19 57

[Signature]

My commission expires 14 September 1960

Notary Public.

**PLUGGING**  
FILE SEC. 30 T. 13 R. 19W  
BOOK PAGE 10 LINE 38

MAY 3 - 1957  
DIVISION

Stickle Drilling Company, Etal  
Wichita, Kansas

Tulsa, Oklahoma  
May 1, 1957

CONTRACTOR: Stickle Drilling Company  
Drilling Commenced: April 19, 1957  
Drilling Completed: April 30, 1957

Martin #1 SW SW NE  
Section 30-13S-19W,  
Ellis County, Kansas.

DRILLERS LOG

1505101287-0000

Depth Figures indicate base of formation:

Post Reck	40
Shale & Shells	210
Shale	855
Red Bed & Sand	925
Sand	1200
Shale & Red Bed	1510
Anhydrite	1545
Shale & Shells	2185
Lime & Shale	2340
Shale & Lime	3065
Lime & Shale	3140
Shale & Lime	3247
Lime & Shale	3597
Lime	3795
Lime Shale & Chert	3829
Lime & Chert	3875
Conglomerate	3911
Conglomerate & Arbuckle	3965 TD

I, Frank E. Stickle hereby certify the above to be a true and complete Drillers Log of Stickle Drilling Company, Etal, Martin #1 SW SW NE Section 30-13S-19W, Ellis County, Kansas.

Frank E. Stickle  
Frank E. Stickle

Lillian T. Bonhann  
Notary Public

February 13, 1960  
My Commission Expires

RECEIVED  
STATE CORPORATION COMMISSION

MAY 3 - 1957

CONSERVATION DIVISION  
Wichita, Kansas

PLUGGING
FILE SEC. 30 T. 13 R. 19W
BOOK PAGE 10 LINE 38