


15:05:2016:00:00
WELL PLUGGING RECORD

Give All Information Completely
Make Required Affidavit
Mail or Deliver Report to:
Conservation Division
State Corporation Commission
212 No. Market
Wichita, Kansas

NORTH

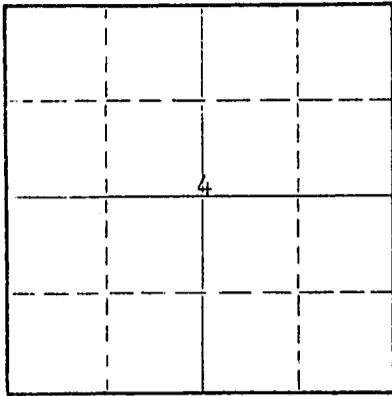

Locate well correctly on above
Section Plat

Ellis County, Sec. 4 Twp. 13S Rge. 20W (E) (W)

Location as "NE/CNWxSWx" or footage from lines SW NE NE/4
Lease Owner Clinton Oil Company
Lease Name Erbert Well No. 1-V
Office Address 6810 W. Highway 54, Wichita, Kansas
Character of Well (completed as Oil, Gas or Dry Hole) Dry
Date well completed November 24 19 67
Application for plugging filed December 12 19 67
Application for plugging approved November 28 19 67
Plugging commenced 10:00 P.M. November 23 19 67
Plugging completed 2:00 A.M. November 24 19 67
Reason for abandonment of well or producing formation Dry

If a producing well is abandoned, date of last production 19
Was permission obtained from the Conservation Division or its agents before plugging was commenced? Yes

Name of Conservation Agent who supervised plugging of this well Leo F. Massey, Box 582, Hays, Kansas.
Producing formation Depth to top Bottom Total Depth of Well 3954 Feet L.T.D.
Show depth and thickness of all water, oil and gas formations.

OIL, GAS OR WATER RECORDS

CASING RECORD

FORMATION	CONTENT	FROM	TO	SIZE	PUT IN	PULLED OUT
				8 5/8"	251'	None

Describe in detail the manner in which the well was plugged, indicating where the mud fluid was placed and the method or methods used in introducing it into the hole. If cement or other plugs were used, state the character of same and depth placed, from feet to feet for each plug set.

Ran 100 sx. 50 - 50 Pozmix 8% gel @ 800', Set Plug, 25 sx. @ 240',
Plug, 10 sx. cement @ 40', 2 sx. cement in Rat Hole.

Job Complete @ 2:00 A.M. Nov. 24, 1967

RECEIVED
STATE CORPORATION COMMISSION

DEC 13 1967

CONSERVATION DIVISION
WICHITA, KANSAS

(If additional description is necessary, use BACK of this sheet)
Name of Plugging Contractor Garvey Drilling Co.
Address Rt. #2 - Great Bend, Kansas

STATE OF KANSAS, COUNTY OF SEDGWICK, ss.
H. Marvin Douglass (employee of owner) or (owner or operator) of the above-described well, being first duly sworn on oath, says: That I have knowledge of the facts, statements, and matters herein contained and the log of the above-described well as filed and that the same are true and correct. So help me God.

(Signature) H. Marvin Douglass
H. Marvin Douglass, Exploration Manager
Clinton Oil Co. - 6810 W. Highway 54, Wichita, Ks.
(Address)

SUBSCRIBED AND SWORN TO before me this 12th day of December, 19 67

My commission expires January 24, 1968

Allen T. Denton
Allen T. Denton Notary Public.

WELL LOG

15-681-20140-00
SEC. 4 T. 13S R. 20W
LOC. SW NE NE

COMPANY Clinton Oil Company


FARM Erbert NO. 1-V

TOTAL DEPTH 3954'

COUNTY Ellis

COMM. 11-13-67 COMP. 11-24-67

CONTRACTOR Garvey Drilling Company

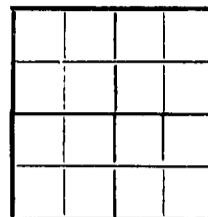

CASING 8 5/8" @ 251' w/185 sx

ELEVATION 2168' KB

PRODUCTION D & A

FIGURES INDICATE BOTTOM OF FORMATIONS

150' Clay
575' Blue Shale
1005' Shale
1070' Sand
1390' Sand and Shale
1426' Shale
1444' Sand
1512' Shale
1592' Anhydrite
2080' Shale
2611' Lime and Shale
2856' Shale with Lime
2959' Lime
3015' Shale, Lime, and Sand
3460' Lime and Shale
3954' Arbuckle
3954' RTD

DEC 13 1967

MINING DIVISION

State of Kansas }
County of Barton } SS

I, Sam N. Stephens of Garvey Drilling Company

upon oath state the above and foregoing is a true and correct copy of the log of the Erbert No. 1-V well.

Sam N. Stephens

Subscribed and sworn to before me this 7th day of December 1967

My Commission Expires: November 5th, 1969

Richard Doy
NOTARY PUBLIC