

STATE OF KANSAS  
STATE CORPORATION COMMISSION  
200 Colorado Derby Bldg.  
Wichita, Kansas 67202


Form CP-4  
Rev. 12-15-80

WELL PLUGGING RECORD

15-057-2314-19W-20

Give All Information Completely  
Make Required Affidavit

COUNTY Ellis SEC. 23 TWP. 13S RGE. 19W NE  
Location as in quarters or footage from lines:  
NW NW NE Sec. 23-13S-19W

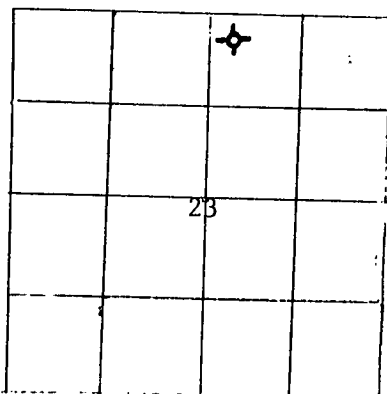

Locate Well  
correctly on above  
Section Platt.

Lease Owner John O. Farmer, Inc.  
Lease Name Befort Well No. #1  
Office Address P.O. Box 352, Russell, KS 67665  
Character of Well (Completed as Oil, Gas or Dry Hole): Dry Hole  
Date Well Completed September 10, 1982  
Application for plugging filed Yes  
Plugging commenced \_\_\_\_\_  
Plugging completed 6:00 A.M., 9-10-82  
Reason for abandonment of well or producing formation \_\_\_\_\_

Was permission obtained from the Conservation Division or it's  
Agent's before plugging was commenced? Yes

Name of Conservation Agent who supervised plugging of this well Carl Goodrow  
Producing formation \_\_\_\_\_ Depth to top \_\_\_\_\_ bottom T.D. 3696'  
Show depth and thickness of all water, oil and gas formations.

OIL, GAS OR WATER RECORDS

Casing Record

| Formation | Content | From | To | Size   | Put in | Pulled Out |
|-----------|---------|------|----|--------|--------|------------|
|           |         |      |    | 8-5/8" | 213'   |            |
|           |         |      |    |        |        |            |
|           |         |      |    |        |        |            |
|           |         |      |    |        |        |            |

Describe in detail the manner in which the well was plugged, indicating where the mud  
fluid was placed and the method or methods used in introducing it into the hold. If cement  
or other plugs were used, state the character of same and depth placed, from \_\_\_\_\_ feet  
to \_\_\_\_\_ feet for each plug set.

Plug #1 @ 750' w/80 sks. cement

Plug #2 @ 225' w/40 sks. cement

Plug #3 @ 40' w/10 sks. cement

(If additional description is necessary, use BACK of this sheet)

Name of Plugging Contractor John O. Farmer, Inc.  
P.O. Box 352, Russell, KS 67665

STATE OF Kansas COUNTY OF Russell, ss.

John O. Farmer (owner or operator) of the  
above-described well, being first duly sworn on oath, says: That I have knowledge of the  
facts, statements, and matters herein contained and the log of the above-described well as  
filed and that the same are true and correct. So help me God.

(Signature)

P.O. Box 352, Russell, KS 67665  
(Address)

SUBSCRIBED AND SWORN TO before me this 15 day of September, 19 82  
My Commission expires: January 27, 1985  
Margaret A. Schulte Notary Public.  
Wichita, Kansas

RECEIVED  
STATE CORPORATION COMMISSION  
SEP 15 1982  
WICHITA, KANSAS

