

STATE OF KANSAS  
STATE CORPORATION COMMISSION

WELL PLUGGING RECORD

OR

FORMATION PLUGGING RECORD

Strike out upper line when reporting plugging of formations.

Give All Information Completely  
Make Required Affidavit  
Mail or Deliver Report to:  
Conservation Division  
State Corporation Commission  
800 Bittling Building  
Wichita, Kansas

Ellis County. Sec. 21 Twp. 11 Rge. 17 (E) West(W)

Location as "NE 1/4 NW 1/4 SW 1/4" or footage from lines 660' from south & 330' from W.

Lease Owner: Phillips Petroleum Company S/2 NE/4

Lease Name: F. Bemis Well No. 5

Office Address: Box, 779, Great Bend, Kansas

Character of Well (completed as Oil, Gas or Dry Hole) Incompleted well a/c fish job

Date, well completed Total Depth reached 10-6-40 193

Application for plugging filed 11-28-1940 193

Application for plugging approved 11-28-40 193


Plugging Commenced 11-28-40 193

Plugging Completed 11-28-40 193

Reason for abandonment of well or producing formation Drill pipe twisted off at 1460 feet and could not recover.

If a producing well is abandoned, date of last production Not producing 193

Was permission obtained from the Conservation Division or its agents before plugging was commenced? Yes, from Mr. C.T. Alexander

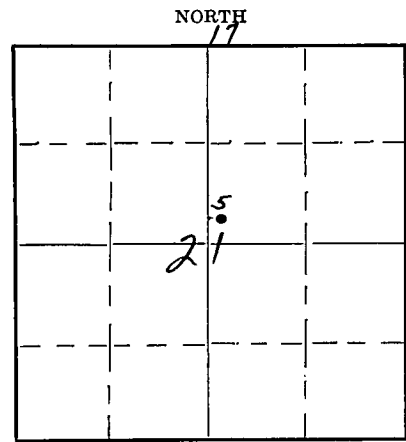

Locate well correctly on above Section Plat

Name of Conservation Agent who supervised plugging of this well C.T. Alexander

Producing formation Not producing Depth to top Bottom Total Depth of Well 3281 Feet

Show depth and thickness of all water, oil and gas formations.

OIL, GAS OR WATER RECORDS

CASING RECORD

Formation	Content	From	To	Size	Put In	Pulled Out
This was a rotary hole and no apparent water, gas or oil was encountered, however the Dakota sand in this area bears water. Top of Dakota probably around 600 ft. Casing was set and cemented thru same.				8 5/8"	1098	None

Describe in detail the manner in which the well was plugged, indicating where the mud fluid was placed and the method or methods used in introducing it into the hole. If cement or other plugs were used, state the character of same and depth placed, from feet to feet for each plug set.

This well spudded 10-25-40. Drilled to 1107 and set the 8 5/8" casing at 1101 ft. with 400 sacks Dewey fibre cement. Good cement returns to cellar. Drilled to total depth of 3281 feet and drill pipe stuck 8 ft. off bottom. Could not loosen so backed off 56 fts. of drill pipe at approximately 1620 ft. leaving 1661 ft. in hole. Ran 50 sacks cement at 1620 ft. thru drill pipe, 11-18-40. On 11-19-40 ran 70 sacks cement at 1600. After cement set found top of cement plug at 1603. Set whipstock and drilled to total depth of 2024 and twisted off drill pipe at 1460 feet. Could not recover drill pipe. Cemented hole thru drill pipe at 1400 feet w/ 150 sacks Dewey fibre cement at 6:00 PM the 27th. Ran drill pipe at 9:30 PM and no cement in hole. Cemented thru drill pipe at 1121 feet w/ 50 sacks Dewey fibre cement @ 10:15 PM. Ran drill pipe at 1:20 AM the 28th and found top of cement at 1005. Filled hole with heavy mud from 1005 to 10 ft. Set bridge and capped hole with 5 sacks cement, filling to bottom of cellar. Hole plugged and abandoned 11-28-40

21 11 17W

123 36

2nd 12-06-40

(If additional description is necessary, use BACK of this sheet)

Correspondence regarding this well should be addressed to Phillips Petroleum Company  
Address: Box 779, Great Bend, Kansas

STATE OF Kansas, COUNTY OF Barton, ss.

I, F.W. Shelton (employee of owner) of the above-described well, being first duly sworn on oath, says: That I have knowledge of the facts, statements, and matters herein contained and the log of the above-described well as filed and that the same are true and correct. So help me God.

(Signature) F.W. Shelton

Box 779, Great Bend, Kansas

(Address)

SUBSCRIBED AND SWORN to before me this 4th day of December, 1940.

My commission expires April 26, 1944

Notary Public.

# Formation Record

Lease

F. Bemis

Well No.

5

FROM	TO	Formation	REMARKS
0	51	Surface and sand	
51	780	Shale	
780	782	Pyrite	
782	<del>873</del>	Shale	
873	1088	Red bed, shale and shells	
1088	1095	Anhydrite	
1095	1108	Anhydrite	
1108	1132	Anhydrite	
1132	1400	Shale	
1400	1450	Salt	
1450	1542	Shale and shells	
1542	2290	Lime, shale and shells	
2290	2401	Shale	
2401	2727	Shale and lime	
2727	2878	Shale	
2878	3281	Lime	
3281		Total Depth	

NOTE - This hole plugged and abandoned 11-28-40

Rig was skidded approximately 50 ft. to southwest to drill well # 5-A.

REC'D  
 NOV 21 11:17 AM '40  
 EOCY 123 36

REC'D  
 STATE DEPT.  
 NOV 21 1940