


Give All Information Completely
Make Required Affidavit
Mail or Deliver Report to:
Conservation Division
State Corporation Commission
211 No. Broadway
Wichita, Kansas

WELL PLUGGING RECORD

Ellis County, Sec. 21 Twp. 11S Rge. 17W (E) W (W)

Location as "NE/CNW&SW&" or footage from lines NW 1/4 SE 1/4 SW 1/4
Lease Owner Ryan Consolidated Petroleum Corporation
Lease Name Frank Bemis "C" Well No. 5"C"
Office Address 3400 Republic National Bank Building, Dallas 1, Texas
Character of Well (completed as Oil, Gas or Dry Hole) ~~Oil Well~~ SLUD
Date well completed August 17 AUG 17 19 38
Application for plugging filed Approximate (Phoned) May 4 19 62
Application for plugging approved No date on letter 19 62
Plugging commenced May 12 19 62
Plugging completed May 12 19 62
Reason for abandonment of well or producing formation collapsed casing

NORTH

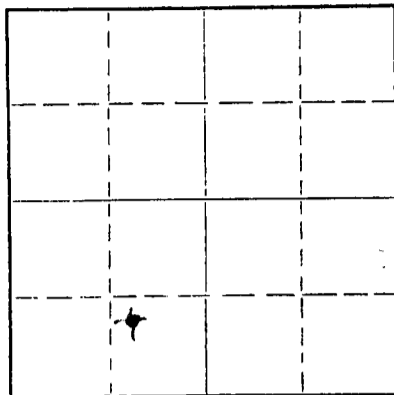

Locate well correctly on above Section Plat

If a producing well is abandoned, date of last production unknown 19
Was permission obtained from the Conservation Division or its agents before plugging was commenced? Yes - by Mr. H. J. Hollis - Great Bend

Name of Conservation Agent who supervised plugging of this well Mr. Eldon Petty
Producing formation Siliceous Lime Depth to top 3439 Bottom 3455 Total Depth of Well 3959 Feet
Show depth and thickness of all water, oil and gas formations.

OIL, GAS OR WATER RECORDS

CASING RECORD

FORMATION	CONTENT	FROM	TO	SIZE	PUT IN	PULLED OUT
Siliceous Lime	Oil	3439	3455	6 5/8	3415	None

Describe in detail the manner in which the well was plugged, indicating where the mud fluid was placed and the method or methods used in introducing it into the hole. If cement or other plugs were used, state the character of same and depth placed, from feet to feet for each plug set. See below

Through tubing to 625 feet due to collapsed casing 40 sax HOWCO Gel Mud pumped by Halliburton - followed by 150 sax cement circulated.

Log on reverse side

Plugging approved by Mr. Petty

8
05-28-62

(If additional description is necessary, use BACK of this sheet)

Name of Plugging Contractor Ryan crew using Halliburton pump trucks
Address

STATE OF TEXAS, COUNTY OF Dallas, ss.

Walter Ziegler (employee of owner) or (owner or operator) of the above-described well, being first duly sworn on oath, says: That I have knowledge of the facts, statements, and matters herein contained and the log of the above-described well as filed and that the same are true and correct. So help me God.

(Signature) Walter Ziegler
3400 Republic Bank Bldg., Dallas 1, Texas
(Address)

SUBSCRIBED AND SWORN TO before me this 25th day of May, 19 62

My commission expires June 1, 1963

Polly Ray Notary Public.



WELL LOG

BEMIS 5 "C"

NW 1/4 SE 1/4 SW 1/4 Sec 21 - 11S-17W
Ellis County, Kansas

<u>Formation</u>	<u>TO</u>	<u>FROM</u>
Surface soil	0	30
Shale and shells	30	500
Sand	500	655
Shale and Shells Red Bd	655	935
Shale and shells	935	1133
Anhydrite	1133	1173
Shale and Red Bed	1173	1245
Red Bed	1245	1314
Shale and shells	1314	1432
Broken Lime	1432	1482
Shale	1482	1495
Salt and shale	1495	1680
Shale and shells	1680	1730
Shale and lime	1730	1812
Broken lime	1812	1860
Shale and lime	1860	2145
Lime, broken Sandy	2145	2182
Lime and shale	2182	2255
Shale and shells	2255	2328
Lime and shale	2328	2383
Broken lime	2383	2432
Shale and lime	2432	2758
Blk Shale and Ls. Shls	2758	2808
Shale and lime	2808	2909
Broken lime	2909	2918
Lime	2918	2969
Shale and lime	2969	2990
Lime	2990	3387
Red Shale	3387	3411
Green Shale	3411	3415
Brown lime	3415	3417
Green Shale	3417	3432
Simpson Sand	3432	3439
Siliceous Lime	3439	3455
Lime and Green Shale	3455	3456
Lime	3456	3534
Lime and Sand	3534	3555
Lime	3555	3571
Lime and Sand	3571	3591
Lime	3591	3882
Lime hard	3882	3893
Lime	3893	3930
Sand	3930	3959